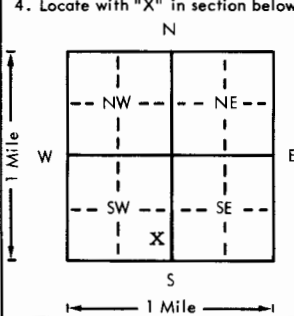


USE TYPEWRITER OR BALL
POINT PEN-PRESS FIRMLY,
PRINT CLEARLY.

WATER WELL RECORD
KSA 82a-1201-1215

Kansas Department of Health and
Environment-Division of Environment
(Water well Contractors)
Topeka, Kansas 66620

1. Location of well:		County Barton	Fraction SE 1/4 SE 1/4 SW 1/4	Section number 23	Township number T 20 S	Range number R 15 E
2. Distance and direction from nearest town or city: 3 miles Northeast of Pawnee Rock, KS Street address of well location if in city:				3. Owner of well: Loren Unruh R.R. or street: 2401 Dove City, state, zip code: Great Bend, KS 67530		
4. Locate with "X" in section below: 				Sketch map:		
5. Type and color of material				6. Bore hole dia. <u>24</u> in. Completion date <u>6-8-77</u> Well depth <u>40</u> ft.		
				7. ☐ Cable tool ☐ Rotary ☐ Driven ☐ Dug ☐ Hollow rod ☐ Jetted ☐ Bored ☒ Reverse rotary		
				8. Use: ☐ Domestic ☐ Public supply ☐ Industry ☒ Irrigation ☐ Air conditioning ☐ Stock ☐ Lawn ☐ Oil field water ☐ Other		
				9. Casing: Material <u>steel</u> Height: <u>above</u> or below Threaded ☐ Welded ☒ Surface <u>12</u> in. RMP ☐ PVC ☐ Weight <u>30.3</u> lbs./ft. Dia. <u>16</u> in. to <u>25</u> ft. depth Wall Thickness: <u>7</u> inches or Dia. <u>16</u> in. to <u>40</u> ft. depth gage No. <u>7 ga</u>		
				10. Screen: Manufacturer's name <u>Cook</u> Type <u>Double-slot</u> Dia. <u>16"</u> ☒ Slot gauze <u>1/8</u> Length <u>10'</u> Set between <u>25</u> ft. and <u>35</u> ft. Gravel pack? <u>yes</u> Size range of material <u>3/8-200</u>		
				11. Static water level: <u>21</u> ft. below land surface Date <u>2-22-77</u>		
				12. Pumping level below land surfaces: <u>N/C</u> ____ ft. after ____ hrs. pumping ____ g.p.m. ____ ft. after ____ hrs. pumping ____ g.p.m. Estimated maximum yield ____ g.p.m.		
				13. Water sample submitted: ____ mo./day/yr. Yes ☒ No ☐ Date ____		
				14. Well head completion: <u>12</u> inches above grade ____ Pitless adapter		
				15. Well grouted? <u>yes</u> With: ☒ Neat cement ☐ Bentonite ☐ Concrete Depth: From <u>0</u> ft. to <u>10</u> ft.		
				16. Nearest source of possible contamination: <u>FIELD</u> ft. ____ Direction ____ Type ____ Well disinfected upon completion? ____ Yes ☒ No ☐		
				17. Pump: <u>Not installed</u> Manufacturer's name <u>Berkeley Pump Co.</u> Model number <u>6S2AM-6</u> HP <u>20</u> Volts <u>460</u> Length of drop pipe <u>30</u> ft. capacity <u>270</u> g.p.m. Type: ☒ Submersible ☐ Turbine ☐ Jet ☐ Reciprocating ☐ Centrifugal ☐ Other		
(Use a second sheet if needed)						
18. Elevation:		19. Remarks:		20. Water well contractor's certification: This well was drilled under my jurisdiction and this report is true to the best of my knowledge and belief. <u>Clarke Well & Eq., inc.</u> 185 Business name <u>Great Bend, KS 67530</u> License No. ____ Address <u>6-9-77</u> Signed <u>[Signature]</u> Date <u>6-9-77</u> Authorized representative		

Forward the white, blue and pink copies to the Department of Health and Environment

Form WWC-5