8831 Well #3

WATER WELL RECORD Form WWC-5 KSA 82a-1212

1 LOCATION OF WATER WELL: County: Barton	Fraction: NW ¼ NW ¼ SW ¼	Section Number: 27	Township Number: T 20 S	Range Number: R 15 E/W

Distance and direction from nearest town or city street address of well if located within city?
Approximately 1 mile north of Pawnee Rock

2 WATER WELL OWNER: Pawnee Rock, City of
RR#, St. Address, Box # : City Hall
City, State, ZIP Code : Pawnee Rock, KS 67567

Board of Agriculture, Division of Water Resources
Application Number: N/A

3 LOCATE WELL'S LOCATION WITH AN "X" IN SECTION BOX:

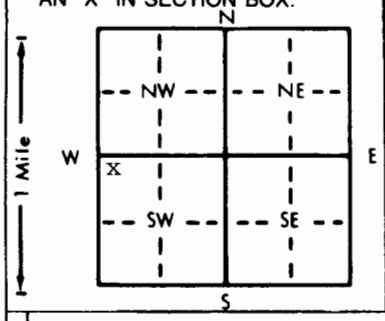

4 DEPTH OF COMPLETED WELL 197 ft. ELEVATION: unknown
Depth(s) Groundwater Encountered 1. ft. 2. ft. 3. ft.
WELL'S STATIC WATER LEVEL 48 ft. below land surface measured on mo/day/yr 4-3-90
Pump test data: Well water was not ch'd ft. after hours pumping gpm
Est. Yield unknown gpm: Well water was ft. after hours pumping gpm
Bore Hole Diameter 9 in. to 195 ft., and in. to ft.
WELL WATER TO BE USED AS: 5 Public water supply 8 Air conditioning 11 Injection well
1 Domestic 3 Feedlot 6 Oil field water supply 9 Dewatering 12 Other (Specify below)
2 Irrigation 4 Industrial 7 Lawn and garden only 10 Monitoring well
Was a chemical/bacteriological sample submitted to Department? Yes X No ; If yes, mo/day/yr sample was submitted 4-9-90 Water Well Disinfected? Yes X No

5 TYPE OF BLANK CASING USED: 5 Wrought iron 8 Concrete tile CASING JOINTS: Glued X Clamped
1 Steel 3 RMP (SR) 6 Asbestos-Cement 9 Other (specify below) Welded
2 PVC 4 ABS 7 Fiberglass Threaded
Blank casing diameter 5 in. to 155 ft., Dia in. to ft., Dia in. to ft.
Casing height above land surface 24 in., weight 2.36 lbs./ft. Wall thickness or gauge No. .214
TYPE OF SCREEN OR PERFORATION MATERIAL: 7 PVC 10 Asbestos-cement
1 Steel 3 Stainless steel 5 Fiberglass 8 RMP (SR) 11 Other (specify)
2 Brass 4 Galvanized steel 6 Concrete tile 9 ABS 12 None used (open hole)
SCREEN OR PERFORATION OPENINGS ARE: 5 Gauzed wrapped 8 Saw cut 11 None (open hole)
1 Continuous slot 3 Mill slot 6 Wire wrapped 9 Drilled holes
2 Louvered shutter 4 Key punched 7 Torch cut 10 Other (specify)
SCREEN-PERFORATED INTERVALS: From 155 ft. to 195 ft., From ft. to ft.
From ft. to ft., From ft. to ft.
GRAVEL PACK INTERVALS: From 30 ft. to 112 ft., From ft. to ft.
From 120 ft. to 195 ft., From ft. to ft.

6 GROUT MATERIAL: 1 Neat cement 2 Cement grout 3 Bentonite 4 Other Bentonite Holeplug
Grout Intervals: From 5 ft. to 25 ft., From 25 ft. to 30 ft., From 112 ft. to 120 ft.
What is the nearest source of possible contamination: 10 Livestock pens 14 Abandoned water well
1 Septic tank 4 Lateral lines 7 Pit privy 11 Fuel storage 15 Oil well/Gas well
2 Sewer lines 5 Cess pool 8 Sewage lagoon 12 Fertilizer storage 16 Other (specify below)
3 Watertight sewer lines 6 Seepage pit 9 Feedyard 13 Insecticide storage None known
Direction from well? How many feet?

FROM	TO	LITHOLOGIC LOG	FROM	TO	PLUGGING INTERVALS
0	28	Topsoil and clay, brown			
28	41	Sandstone, hard and soft and			
		streaks of clay, yellow and white			
41	56	Clay, red and yellow and white			
56	106	Clay, gray			
106	112	Streaks of sandstone and streaks			
		clay, gray, hard streak at 110'			
112	154	Clay, gray			
154	195	Sandstone, brown, soft with few			
		thin clay streaks, thick clay			
		streaks at 179 and 181			

7 CONTRACTOR'S OR LANDOWNER'S CERTIFICATION: This water well was (1) constructed, (2) reconstructed, or (3) plugged under my jurisdiction and was completed on (mo/day/year) 4-3-90 and this record is true to the best of my knowledge and belief. Kansas Water Well Contractor's License No. 185 This Water Well Record was completed on (mo/day/yr) 9-8-92
under the business name of Clarke Well & Equipment, Inc. by (signature) [signature]

INSTRUCTIONS: Use typewriter or ball point pen. *PLEASE PRESS FIRMLY* and *PRINT* clearly. Please fill in blanks, underline or circle the correct answers. Send top three copies to Kansas Department of Health and Environment, Bureau of Water, Topeka, Kansas 66620-0001. Telephone: 913-296-5545. Send one to WATER WELL OWNER and retain one for your records.

OFFICE USE ONLY T R E/W SEC. ¼ ¼ ¼