

WATER WELL PLUGGING RECORD Form WWC-5P

KSA 82a-1212

ID NO.

35269

1 LOCATION OF WATER WELL:County: **Barton**

Fraction

1/4 SE 1/4 SE 1/4 NE 1/4

Section Number

24

Township Number

T 20 S

Range Number

15

☐ E☒ W

Street/Rural Address of Well Location; if unknown, distance & direction from nearest town or intersection: If at owner's address, check here ☐

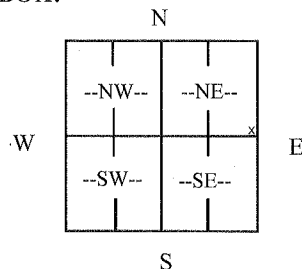
Approximately 2 miles north and 3 miles east of Pawnee Rock.

Global Positioning Systems (GPS) information:Latitude: 38.296507 (in decimal degrees)Longitude: -98.921887 (in decimal degrees)Elevation: unknownDatum: ☐ WGS84, ☒ NAD83, ☐ NAD27

Collection Method:

☒ GPS unit (Make/Model): WAAS☐ Digital Map/Photo, ☐ Topographic Map, ☐ Land SurveyEst. Accuracy: ☐ < 3 m, ☒ 3-5 m, ☐ 5-15 m, ☐ > 15 m**2 WATER WELL OWNER:**

Jim Romine

RR#, St. Address, Box #: 51 SW 60th Ave.City, State ZIP Code: Great Bend, KS 67530**3 MARK WELL'S LOCATION WITH AN "X" IN SECTION BOX:****4 DEPTH OF WELL** 76.50 **ft.**WELL'S STATIC WATER LEVEL 16 **ft**

WELL WAS USED AS:

☐ Domestic☐ Irrigation☐ Feedlot☐ Industrial☐ Public Water Supply☐ Oil Field Water Supply☐ Domestic (Lawn & Garden)☐ Air Conditioning☐ Dewatering☐ Monitoring☐ Injection Well☒ Other Test WellWas a chemical/bacteriological sample submitted to Department? Yes ☐ No ☒**5 TYPE OF BLANK CASING USED:**☐ Steel☐ RMP (SR)☐ Wrought☐ Fiberglass☐ Other (Specify below)☒ PVC☐ ABS☐ Asbestos-Cement☐ Concrete TileBlank casing diameter 2 in. Was casing pulled? Yes ☐ No ☒Casing height above or below land surface. 48 in.**6 GROUT PLUG MATERIAL:**☐ Neat cement☐ Cement grout☒ Bentonite☐ OtherGrout Plug Intervals: From _____ ft. to _____ ft., From 4 ft. to 76.50 ft., From _____ to _____ ft.

What is the nearest source of possible contamination:

☐ Septic tank☐ Seepage pit☐ Fuel Storage☒ Other (specify below)☐ Sewer lines☐ Pit privy☐ Fertilizer storageNone Known☐ Watertight sewer lines☐ Sewage lagoon☐ Insecticide storage☐ Lateral lines☐ Feedyard☐ Abandoned water well

Direction from well? _____

☐ Cess pool☐ Livestock pens☐ Oil well/Gas well

How many feet? _____

FROM	TO	PLUGGING MATERIALS	FROM	TO	PLUGGING MATERIALS
0	4	Topsoil			
4	76.50	Bentonite Chips			

7 CONTRACTOR'S OR LANDOWNER'S CERTIFICATION:

This water well was plugged under my jurisdiction and was completed on (mo/day/year) 01/11/12 and this record is true to the best of my knowledge and belief. Kansas Water Well Contractor's License No. 185. This Water Well Record was completed on (mo/day/year) 01/12/12 under the business name of Clarke Well & Equipment, Inc. by (signature) [Signature]

INSTRUCTIONS: Use typewriter or ballpoint pen. Please press firmly and print clearly. Please fill in blanks, underline or circle the correct answers. Send top three copies to Kansas Department of Health and Environment, Bureau of Water, Geology Section, 1000 SW Jackson St., Ste. 420, Topeka, Kansas 66612-1367. Telephone: 785/296-5524. Send one to Water Well Owner and retain one for your records. Visit us at <http://www.kdheks.gov/waterwell/index.html>.

Check one:

☒ White Copy☐ Blue Copy☐ Pink Copy