USE TYPEWRITER OR BALL POINT PEN-PRESS FIRMLY, PRINT CLEARLY.

WATER WELL RECORD
KSA 82a-1201-1215

Kansas Department of Health and Environment-Division of Environment
(Water well Contractors)
Topeka, Kansas 66620

1. Location of well:	County	Fraction	Section number	Township number	Range number
	Pawnee	sw 1/4 sw 1/4 se 1/4	26	T 20 S	R 16w E/W

2. Distance and direction from nearest town or city: 4w 1n
Street address of well location if in city: Pawnee Rock, Ks.

3. Owner of well: Woodman-Iannitti Drlg Co.
R.R. or street: Box 308
City, state, zip code: Great Bend, Ks. 67530

4. Locate with "X" in section below:

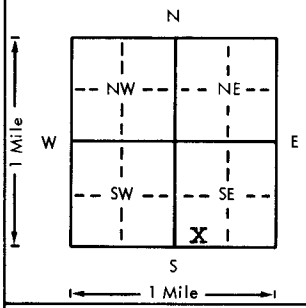

Sketch map:

6. Bore hole dia. 8 in. Completion date _____
Well depth 232 ft. 11-12-77

7. __ Cable tool X Rotary __ Driven __ Dug
__ Hollow rod __ Jetted __ Bored __ Reverse rotary

8. Use: __ Domestic __ Public supply __ Industry
__ Irrigation __ Air conditioning __ Stock
__ Lawn X Oil field water __ Other

9. Casing: Material _____ Height: Above XXXX
Threaded ____ Welded ____ Surface 12 in.
RMP ____ PVC X Weight _____ lbs./ft.
Dia. 5 in. to 232 ft. depth Wall Thickness: inches or
Dia. ____ in. to ____ ft. depth gage No. sch 40

10. Screen: Manufacturer's name Jetstream
Type pvc Dia. 5"
Slot/gauze 1/16" Length 40'
Set between 192 ft. and 232 ft.
____ ft. and ____ ft.
Gravel pack? X Size range of material 1/8-3/4"

11. Static water level: mo./day/yr.
95 ft. below land surface Date 11-12-77

12. Pumping level below land surfaces:
____ ft. after ____ hrs. pumping ____ g.p.m.
____ ft. after ____ hrs. pumping ____ g.p.m.
Estimated maximum yield 50 g.p.m.

13. Water sample submitted: mo./day/yr.
__ Yes X No Date _____

14. Well head completion:
__ Pitless adapter X Inches above grade

15. Well grouted? X
With: __ Neat cement X Bentonite __ Concrete
Depth: From 0 ft. to 10 ft.

16. Nearest source of possible contamination: oil
ft. 75 Direction se Type test
Well disinfected upon completion? ____ Yes X No

17. Pump: __ Not installed
Manufacturer's name Goulds
Model number utm HP 3 Volts 230
Length of drop pipe 168 ft. capacity 45 g.p.m.
Type:
X Submersible __ Turbine
__ Jet __ Reciprocating
__ Centrifugal __ Other

5. Type and color of material	From	To
Top Soil-Clay	0	30
Shale	30	180
Sand Rock	180	232

(Use a second sheet if needed)

18. Elevation:

Topography:
X Hill
__ Slope
__ Upland
__ Valley

19. Remarks:

20. Water well contractor's certification:
This well was drilled under my jurisdiction and this report is true to the best of my knowledge and belief.
Kellys Waterwell Ser 186
Business name License No.
Address R2 Great Bend, Ks.
Signed Kelly Price Date 8-9-79
Authorized representative

T 20 R 16 (W) Sec 26 1/4 SW SE 1/4

Forward the white, blue and pink copies to the Department of Health and Environment

Form WWC-5

MI-1023