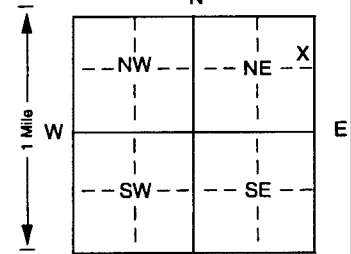


1 LOCATION OF WATER WELL:		Fraction		Section Number		Township Number		Range Number	
County: Pawnee		SW 1/4 SW 1/4 NE 1/4		10		T 20 S		R 17 E (W)	
Distance and direction from nearest town or city street address of well if located within city?									
Approximately 1 1/2 miles north and 1 1/2 miles east of Ash Valley									
2 WATER WELL OWNER: Margaret Spreier									
RR#, St. Address, Box #: Route 1 - Box 64					Board of Agriculture, Division of Water Resources				
City, State, ZIP Code: Larned, KS 67550					Application Number:				
3 LOCATE WELL'S LOCATION WITH AN "X" IN SECTION BOX:		4 DEPTH OF COMPLETED WELL 102 ft. ELEVATION: unknown							
		Depth(s) Groundwater Encountered 1 ft. 2 ft. 3 ft. ft.							
		WELL'S STATIC WATER LEVEL 39.33 ft. below land surface measured on mo/day/yr 10-23-03							
		Pump test data: Well water was not checked ft. after hours pumping gpm							
		Est. Yield unknown gpm: Well water was ft. after hours pumping gpm							
		Bore Hole Diameter 8 in. to 100 ft., and in. to ft.							
		WELL WATER TO BE USED AS: 5 Public water supply 8 Air conditioning 11 Injection well							
		1 Domestic 3 Feedlot 6 Oil field water supply 9 Dewatering 12 Other (specify below)							
		2 Irrigation 4 Industrial 7 Domestic (lawn & garden) 10 Monitoring well Stock Well							
		Was a chemical/bacteriological sample submitted to Department? Yes No If yes, mo/day/yr sample was submitted							
		Water Well Disinfected? Yes No							
5 TYPE OF BLANK CASING USED:									
1 Steel 3 RMP (SR) 5 Wrought iron 8 Concrete tile CASING JOINTS: Glued Clamped									
2 PVC 4 ABS 6 Asbestos-Cement 9 Other (specify below) Welded									
7 Fiberglass Threaded									
Blank casing diameter 5 in. to 65 ft., Dia 5 in. to 100 ft., Dia in. to ft.									
Casing height above land surface 24 in., weight 2.36 lbs./ft. Wall thickness or gauge No .214									
TYPE OF SCREEN OR PERFORATION MATERIAL:									
1 Steel 3 Stainless steel 5 Fiberglass 8 RMP (SR) 10 Asbestos-cement									
2 Brass 4 Galvanized steel 6 Concrete tile 9 ABS 11 Other (specify)									
12 None used (open hole)									
SCREEN OR PERFORATION OPENINGS ARE:									
1 Continuous slot 3 Mill slot 5 Gauzed wrapped 8 Saw cut 11 None (open hole)									
2 Louvered shutter 4 Key punched 6 Wire wrapped 9 Drilled holes									
3 Torch cut 10 Other (specify) ft.									
SCREEN-PERFORATED INTERVALS: From 65 ft. to 95 ft., From ft. to ft.									
GRAVEL PACK INTERVALS: From 20 ft. to 50 ft., From ft. to ft.									
From 58 ft. to 105 ft., From ft. to ft.									
6 GROUT MATERIAL: 1 Neat cement 2 Cement grout 3 Bentonite 4 Other Bentonite Holeplug									
Grout Intervals: From ft. to ft., From 0 ft. to 20 ft., From 50 ft. to 58 ft.									
What is the nearest source of possible contamination:									
1 Septic tank 4 Lateral lines 7 Pit privy 10 Livestock pens 14 Abandoned water well									
2 Sewer lines 5 Cess pool 8 Sewage lagoon 11 Fuel storage 15 Oil well/Gas well									
3 Watertight sewer lines 6 Seepage pit 9 Feedyard 12 Fertilizer storage 16 Other (specify below)									
13 Insecticide storage None known									
Direction from well? How many feet?									
FROM TO LITHOLOGIC LOG FROM TO PLUGGING INTERVALS									
0 5 Topsoil									
5 13 Clay, brown									
13 37 Clay, yellow with limestone									
37 68 Clay, black and gray with rock streaks									
68 85 Clay, gray with sandstone									
85 95 Clay, gray and white with sandstone									
95 100 Dakota Clay									
7 CONTRACTOR'S OR LANDOWNER'S CERTIFICATION: This water well was (1) constructed (2) reconstructed or (3) plugged under my jurisdiction and was completed on (mo/day/year) 10-23-03 and this record is true to the best of my knowledge and belief. Kansas Water Well Contractor's License No 185 This Water Well Record was completed on (mo/day/yr) 10-29-03 under the business name of Clarke Well & Equipment, Inc. by (signature)									
INSTRUCTIONS: Use typewriter or ball point pen. PLEASE PRESS FIRMLY and PRINT clearly. Please fill in blanks, underline or circle the correct answers. Send top three copies to Kansas Department of Health and Environment, Bureau of Water, Topeka, Kansas 66620-0001. Telephone 785-296-5524. Send one to WATER WELL OWNER and retain one for your records. Fee of \$5.00 for each constructed well.									