

LOCATION OF WATER WELL:	Fraction	Section Number	Township Number	Range Number
County: Pawnee	SW 1/4 SW 1/4 NW 1/4	5	T 20 S	R 17 E/W

Distance and direction from nearest town or city street address of well if located within city?

Approximately 2 3/4 miles north and 1 mile west of Ash Valley

WATER WELL OWNER: George Seeman

R#, St. Address, Box #: Route 1 - Box 62

Board of Agriculture, Division of Water Resources

City, State, ZIP Code: Larned, KS 67550

Application Number:

LOCATE WELL'S LOCATION WITH AN "X" IN SECTION BOX:

N	
W	E
SW	SE
S	

DEPTH OF COMPLETED WELL: 174 ft. ELEVATION: unknown

Depth(s) Groundwater Encountered 1. ft. 2. ft. 3. ft.

WELL'S STATIC WATER LEVEL 43 ft. below land surface measured on mo/day/yr 3-28-92

Pump test data: Well water was not ch'd. ft. after hours pumping gpm

Est. Yield unknown gpm: Well water was ft. after hours pumping gpm

Bore Hole Diameter 8. 3/4 in. to 178 ft. and in. to ft.

WELL WATER TO BE USED AS: 5 Public water supply 8 Air conditioning 11 Injection well

1 Domestic 3 Feedlot 6 Oil field water supply 9 Dewatering 12 Other (Specify below)

2 Irrigation 4 Industrial 7 Lawn and garden only 10 Monitoring well Stock

Was a chemical/bacteriological sample submitted to Department? Yes No X; If yes, mo/day/yr sample was submitted

Water Well Disinfected? Yes X No

TYPE OF BLANK CASING USED:

1 Steel	3 RMP (SR)	6 Asbestos-Cement	9 Other (specify below)
2 PVC	4 ABS	7 Fiberglass	

CASING JOINTS: Glued X Clamped

Welded

Threaded

Blank casing diameter 5 in. to 132 ft. Dia in. to ft. Dia in. to ft.

Casing height above land surface 24 in. weight 2.36 lbs./ft. Wall thickness or gauge No. 214

TYPE OF SCREEN OR PERFORATION MATERIAL:

1 Steel	3 Stainless steel	5 Fiberglass	8 RMP (SR)	11 Other (specify)
2 Brass	4 Galvanized steel	6 Concrete tile	9 ABS	12 None used (open hole)

7 PVC

10 Asbestos-cement

SCREEN OR PERFORATION OPENINGS ARE:

1 Continuous slot	3 Mill slot	6 Wire wrapped	9 Drilled holes
2 Louvered shutter	4 Key punched	7 Torch cut	10 Other (specify)

8 Saw cut

11 None (open hole)

SCREEN-PERFORATED INTERVALS: From 132 ft. to 172 ft. From ft. to ft.

From ft. to ft. From ft. to ft.

GRAVEL PACK INTERVALS: From 20 ft. to 178 ft. From ft. to ft.

From ft. to ft. From ft. to ft.

GROUT MATERIAL:

1 Neat cement 2 Cement grout 3 Bentonite 4 Other Bentonite Haleplug

Grout intervals: From ft. to ft. From ft. to ft. From 0 ft. to 20 ft.

What is the nearest source of possible contamination:

1 Septic tank	4 Lateral lines	7 Pit privy	10 Livestock pens	14 Abandoned water well
2 Sewer lines	5 Cess pool	8 Sewage lagoon	11 Fuel storage	15 Oil well/Gas well
3 Watertight sewer lines	6 Seepage pit	9 Feedyard	12 Fertilizer storage	16 Other (specify below)
			13 Insecticide storage	None known

Direction from well?

How many feet?


FROM	TO	LITHOLOGIC LOG	FROM	TO	PLUGGING INTERVALS
0	4	Topsoil			
4	10	Clay, brown			
10	30	Clay, yellow and white, hard			
30	96	Shale, black, streaks of limestone, hard			
96	98	Clay, white, soft, sandy			
98	118	Shale, black, hard, silty			
118	130	Shale, brown, hard			
130	132	Shale, black, hard			
132	138	Sandstone, brown, fine, loose, clean			
138	161	Sandstone, gray, fine, medium, loose, clean			
161	178	Sandstone, brown, fine, loose, clean			

CONTRACTOR'S OR LANDOWNER'S CERTIFICATION: This water well was (1) constructed, (2) reconstructed, or (3) plugged under my jurisdiction and was completed on (mo/day/year) 3-28-92 and this record is true to the best of my knowledge and belief. Kansas

Water Well Contractor's License No. 185 This Water Well Record was completed on (mo/day/yr) 4-20-92

Under the business name of Clarke Well & Equipment, Inc.

by (signature)

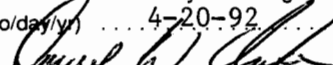

INSTRUCTIONS: Use typewriter or ball point pen. PLEASE PRESS FIRMLY and PRINT clearly. Please fill in blanks, underline or circle the correct answers. Send top three copies to Kansas Department of Health and Environment, Bureau of Water, Topeka, Kansas 66620-0001. Telephone: 913-296-5545. Send one to WATER WELL OWNER and retain one for your records.