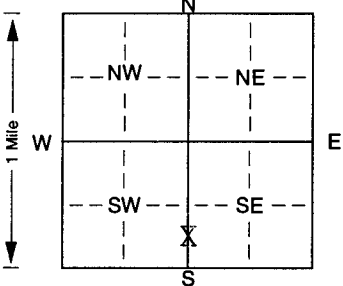


1] LOCATION OF WATER WELL: County: Pawnee	Fraction N 1/4 C 1/4 S 1/2 1/4	Section Number 32	Township Number T 20 S	Range Number R 18 X W
--	--	----------------------	---------------------------	-------------------------------------

Distance and direction from nearest town or city street address of well if located within city?
5 3/4 north, 1 1/4 west of Sanford, KS

2] WATER WELL OWNER: John Woelk
RR#, St. Address, Box #: Rt. 1 Box 26
City, State, ZIP Code: Rozel, KS 67574
Board of Agriculture, Division of Water Resources
Application Number: 44,519

3] LOCATE WELL'S LOCATION WITH AN "X" IN SECTION BOX: 	4] DEPTH OF COMPLETED WELL: 194 ft. ELEVATION: Depth(s) Groundwater Encountered 1 ft. 2 ft. 3 ft. WELL'S STATIC WATER LEVEL 25 ft. below land surface measured on mo/day/yr 1-9-02 Pump test data: Well water was ... ft. after ... hours pumping ... gpm Est. Yield 700 gpm; Well water was 121 ft. after 6 hours pumping 675 gpm Bore Hole Diameter 28 in. to 193 ft., and ... in. to ... ft. WELL WATER TO BE USED AS: 5 Public water supply 8 Air conditioning 11 Injection well 1 Domestic 3 Feedlot 6 Oil field water supply 9 Dewatering 12 Other (Specify below) 2 Irrigation 4 Industrial 7 Domestic (lawn & garden) 10 Monitoring well Was a chemical/bacteriological sample submitted to Department? Yes ... No <input checked="" type="checkbox"/> ; If yes, mo/day/yr sample was submitted ... Water Well Disinfected? Yes ... No <input checked="" type="checkbox"/>
---	---

5] TYPE OF BLANK CASING USED:
1 Steel 3 RMP (SR) 5 Wrought iron 8 Concrete tile CASING JOINTS: Glued Clamped ...
2 PVC 4 ABS 6 Asbestos-Cement 9 Other (specify below) Welded ...
7 Fiberglass Threaded ...
Blank casing diameter 16 in. to 114 ft., Dia ... in. to ... ft., Dia ... in. to ... ft.
Casing height above land surface 12 in., weight sch 40 lbs./ft. Wall thickness or gauge No. ...
TYPE OF SCREEN OR PERFORATION MATERIAL:
1 Steel 3 Stainless steel 5 Fiberglass 7 PVC 10 Asbestos-cement
2 Brass 4 Galvanized steel 6 Concrete tile 8 RMP (SR) 11 Other (specify) ...
9 ABS 12 None used (open hole)
SCREEN OR PERFORATION OPENINGS ARE:
1 Continuous slot 3 Mill slot 5 Gauzed wrapped 8 Saw cut 11 None (open hole)
2 Louvered shutter 4 Key punched 6 Wire wrapped 9 Drilled holes
7 Torch cut 10 Other (specify) ... ft.
SCREEN-PERFORATED INTERVALS: From 114 ft. to 193 ft., From ... ft. to ... ft.
GRAVEL PACK INTERVALS: From 193 ft. to 20 ft., From ... ft. to ... ft.

6] GROUT MATERIAL: 1 Neat cement 2 Cement grout 3 Bentonite 4 Other hole plug
Grout Intervals: From 20 ft. to 0 ft., From ... ft. to ... ft., From ... ft. to ... ft.
What is the nearest source of possible contamination:
1 Septic tank 4 Lateral lines 7 Pit privy 10 Livestock pens 14 Abandoned water well
2 Sewer lines 5 Cess pool 8 Sewage lagoon 11 Fuel storage 15 Oil well/Gas well
3 Watertight sewer lines 6 Seepage pit 9 Feedyard 12 Fertilizer storage 16 Other (specify below)
13 Insecticide storage None
Direction from well? How many feet?

FROM	TO	LITHOLOGIC LOG	FROM	TO	PLUGGING INTERVALS
0	3	top soil	160	193	sand rock
3	14	silty brown clay			
14	17	brown clay			
17	23	tan clay			
23	25	sand and gravel			
25	45	brown clay			
45	57	sand and gravel, rock, brown clay			
57	67	fire clay			
67	69	sand rock			
69	71	gray shale			
71	81	sand rock			
81	90	yellow brown clay			
90	147	sand rock			
147	160	gray shale			

7] CONTRACTOR'S OR LANDOWNER'S CERTIFICATION: This water well was (1) constructed, (2) reconstructed, or (3) plugged under my jurisdiction and was completed on (mo/day/year) 3-14-02 and this record is true to the best of my knowledge and belief. Kansas Water Well Contractor's Licence No. 134 This Water Well Record was completed on (mo/day/yr) 3-21-02 under the business name of Rosencrantz-Bemis by (signature) Fredrick Hadson