


1 LOCATION OF WATER WELL: County: <u>Pawnee</u>	Fraction <u>SW 1/4 SW 1/4 SE 1/4</u>	Section Number <u>14</u>	Township Number <u>T 20 S</u>	Range Number <u>R 18 E/W</u>
--	---	-----------------------------	----------------------------------	---------------------------------

Distance and direction from nearest town or city street address of well if located within city?
9 miles west and 8 miles north of Larned, Kansas

2 WATER WELL OWNER: Dallas Heibert
 RR#, St. Address, Box # : _____
 City, State, ZIP Code : Rozel, Kansas 67574
 Board of Agriculture, Division of Water Resources
 Application Number: _____

3 LOCATE WELL'S LOCATION WITH AN "X" IN SECTION BOX:

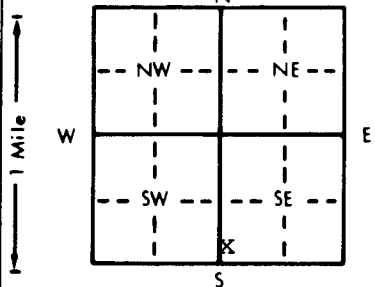

4 DEPTH OF COMPLETED WELL: 248 ft. ELEVATION: Upland
 Depth(s) Groundwater Encountered 1. 188 ft. 2. 225 ft. 3. _____ ft.
 WELL'S STATIC WATER LEVEL 170 ft. below land surface measured on mo/day/yr 6/21/90
 Pump test data: Well water was 175 ft. after 4 hours pumping 15 gpm
 Est. Yield 15 gpm: Well water was _____ ft. after _____ hours pumping _____ gpm
 Bore Hole Diameter 10 in. to 248 ft., and _____ in. to _____ ft.
 WELL WATER TO BE USED AS: 1 5 Public water supply 8 Air conditioning 11 Injection well
1 Domestic 3 Feedlot 6 Oil field water supply 9 Dewatering 12 Other (Specify below)
2 Irrigation 4 Industrial 7 Lawn and garden only 10 Monitoring well
 Was a chemical/bacteriological sample submitted to Department? Yes _____ No X; If yes, mo/day/yr sample was submitted _____
 Water Well Disinfected? Yes X No _____

5 TYPE OF BLANK CASING USED: 2 _____ 5 Wrought iron 8 Concrete tile CASING JOINTS: Glued X Clamped _____
 1 Steel 3 RMP (SR) 6 Asbestos-Cement 9 Other (specify below) Welded _____
 2 PVC 4 ABS 7 Fiberglass _____ Threaded _____

Blank casing diameter 5 in. to 228 ft., Dia _____ in. to _____ ft., Dia _____ in. to _____ ft.
 Casing height above land surface 24 in., weight 2.29 lbs./ft. Wall thickness or gauge No. 26

TYPE OF SCREEN OR PERFORATION MATERIAL: 7 _____ 7 PVC 10 Asbestos-cement
 1 Steel 3 Stainless steel 5 Fiberglass 8 RMP (SR) 11 Other (specify) _____
 2 Brass 4 Galvanized steel 6 Concrete tile 9 ABS 12 None used (open hole)

SCREEN OR PERFORATION OPENINGS ARE: 8 _____ 5 Gauzed wrapped 8 Saw cut 11 None (open hole)
 1 Continuous slot 3 Mill slot 6 Wire wrapped 9 Drilled holes
 2 Louvered shutter 4 Key punched 7 Torch cut 10 Other (specify) _____

SCREEN-PERFORATED INTERVALS: From 228 ft. to 248 ft., From _____ ft. to _____ ft.
 From _____ ft. to _____ ft., From _____ ft. to _____ ft.
 GRAVEL PACK INTERVALS: From 150 ft. to 248 ft., From _____ ft. to _____ ft.
 From _____ ft. to _____ ft., From _____ ft. to _____ ft.

6 GROUT MATERIAL: 1 1 Neat cement 2 Cement grout 3 Bentonite 4 Other _____
 Grout Intervals: From 228 ft. to 35 ft., From _____ ft. to _____ ft., From _____ ft. to _____ ft.

What is the nearest source of possible contamination: None
 1 Septic tank 4 Lateral lines 7 Pit privy 10 Livestock pens 14 Abandoned water well
 2 Sewer lines 5 Cess pool 8 Sewage lagoon 11 Fuel storage 15 Oil well/Gas well
 3 Watertight sewer lines 6 Seepage pit 9 Feedyard 12 Fertilizer storage 16 Other (specify below)
 13 Insecticide storage _____

Direction from well? _____ How many feet? _____

FROM	TO	LITHOLOGIC LOG	FROM	TO	PLUGGING INTERVALS
0	3	Topsoil			
3	8	Gumbo			
8	23	Rock layers and gumbo			
23	120	Shale			
120	155	Gray clay			
155	170	Red clay			
170	175	Gray clay			
175	188	Red clay			
188	218	Sand rock			
218	225	Hard sand rock			
225	235	Sand rock			
235	248	Red clay			

7 CONTRACTOR'S OR LANDOWNER'S CERTIFICATION: This water well was (1) constructed, (2) reconstructed, or (3) plugged under my jurisdiction and was completed on (mo/day/year) 6/21/90 and this record is true to the best of my knowledge and belief. Kansas Water Well Contractor's License No. 199 This Water Well Record was completed on (mo/day/yr) 10/27/90 under the business name of Karst Water Well Drilling & Service, Inc. by (signature) _____