


1 LOCATION OF WATER WELL: County: Pawnee	Fraction NE 1/4 NE 1/4 NE 1/4	Section Number 17	Township Number T 20 S	Range Number R 19 E/W
---	----------------------------------	----------------------	---------------------------	--------------------------

Distance and direction from nearest town or city street address of well if located within city?

Approximately 8 1/2 miles north and 2 miles west of Rozel

2 WATER WELL OWNER: RR#, St. Address, Box # : City, State, ZIP Code :	Orville Snodgrass Route 1 - Box 51A Nekoma, KS 67559	Board of Agriculture, Division of Water Resources Application Number:
---	--	--

3 LOCATE WELL'S LOCATION WITH AN "X" IN SECTION BOX:

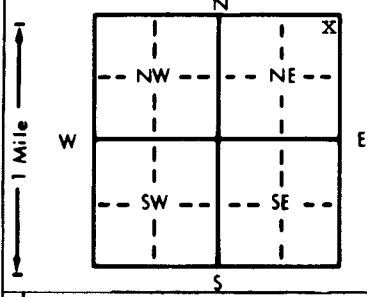

4 DEPTH OF COMPLETED WELL: 292 ft. ELEVATION: unknown
Depth(s) Groundwater Encountered 1. ft. 2. ft. 3. ft.
WELL'S STATIC WATER LEVEL . . . 170 . . . ft. below land surface measured on mo/day/yr . . . 3-24-99
Pump test data: Well water was not ch'd. ft. after hours pumping gpm
Est. Yield unknown gpm: Well water was ft. after hours pumping gpm
Bore Hole Diameter . . . 8 3/4 . . . in. to . . . 295 . . . ft., and in. to ft.
WELL WATER TO BE USED AS:
1 Domestic 3 Feedlot 6 Oil field water supply 9 Dewatering 12 Other (Specify below)
2 Irrigation 4 Industrial 7 Lawn and garden only 10 Monitoring well
WAS a chemical/bacteriological sample submitted to Department? Yes No X; If yes, mo/day/yr sample was sub- mitted
Water Well Disinfected? Yes X No

5 TYPE OF BLANK CASING USED:	5 Wrought iron	8 Concrete tile	CASING JOINTS: Glued . . . X . . . Clamped
1 Steel	3 RMP (SR)	6 Asbestos-Cement	9 Other (specify below)
2 PVC	4 ABS	7 Fiberglass	10 Asbestos-cement
Blank casing diameter . . . 4 1/2 . . . in. to . . . 260 . . . ft., Dia in. to ft., Dia in. to ft.			11 Injection well
Casing height above land surface . . . 24 . . . in., weight . . . 2.38 . . . lbs./ft. Wall thickness or gauge No. . . . 248			12 Other (Specify below)
TYPE OF SCREEN OR PERFORATION MATERIAL:	7 PVC		
1 Steel	3 Stainless steel	5 Fiberglass	8 RMP (SR)
2 Brass	4 Galvanized steel	6 Concrete tile	9 ABS
SCREEN OR PERFORATION OPENINGS ARE:	5 Gauzed wrapped	8 Saw cut	11 None (open hole)
1 Continuous slot	3 Mill slot	6 Wire wrapped	9 Drilled holes
2 Louvered shutter	4 Key punched	7 Torch cut	10 Other (specify)
SCREEN-PERFORATED INTERVALS:	From . . . 260 . . . ft. to . . . 290 . . . ft., From ft. to ft.		
GRAVEL PACK INTERVALS:	From . . . 250 . . . ft. to . . . 295 . . . ft., From ft. to ft.		

6 GROUT MATERIAL:	1 Neat cement	2 Cement grout	3 Bentonite	4 Other	50% Sand & 50% Bentonite
Grout Intervals: From . . . 0 . . . ft. to . . . 21 . . . ft., From . . . 21 . . . ft. to . . . 190 . . . ft., From . . . 190 . . . ft. to . . . 250 . . . ft.	Bentonite Holeplug	Chlorinated sand	Bentonite Holeplug		
What is the nearest source of possible contamination:	1 Septic tank	4 Lateral lines	7 Pit privy	10 Livestock pens	14 Abandoned water well
2 Sewer lines	5 Cess pool	8 Sewage lagoon	11 Fuel storage	12 Fertilizer storage	15 Oil well/Gas well
3 Watertight sewer lines	6 Seepage pit	9 Feedyard	13 Insecticide storage	16 Other (specify below)	House
Direction from well? North			How many feet? 154'		

FROM	TO	LITHOLOGIC LOG	FROM	TO	PLUGGING INTERVALS
0	4	Topsoil			
4	13	Clay, brown			
13	16	Post Rock			
16	40	Clay, brown			
40	55	Shale, gray			
55	60	Shale, black			
60	212	Shale, gray			
212	257	Shale, red, gray			
257	280	Sandstone			
280	295	Shale, gray			

7 CONTRACTOR'S OR LANDOWNER'S CERTIFICATION: This water well was (1) constructed, (2) reconstructed, or (3) plugged under my jurisdiction and was completed on (mo/day/year) . . . 3/24/99 and this record is true to the best of my knowledge and belief. Kansas Water Well Contractor's License No. . . . 185 This Water Well Record was completed on (mo/day/yr) . . . 3/25/99 under the business name of Clarke Well & Equipment, Inc. by (signature) *Clarke Well & Equipment, Inc.*

INSTRUCTIONS: Use typewriter or ball point pen. PLEASE PRESS FIRMLY and PRINT clearly. Please fill in blanks, underline or circle the correct answers. Send top three copies to Kansas Department of Health and Environment, Bureau of Water, Topeka, Kansas 66620-0001. Telephone: 913-296-5545. Send one to WATER WELL OWNER and retain one for your records.

OFFICE USE ONLY

T

R

EW

SEC.

1/4

1/4

1/4