


8 mi N of Moundridge

Board of Agriculture, Division of Water Resources
Application Number:

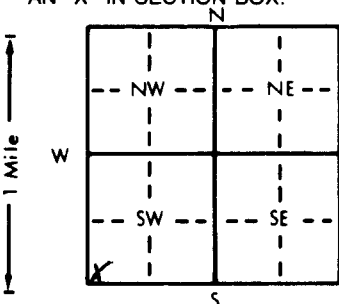

Depth(s) Groundwater Encountered 1. _____ ft. 2. _____ ft. 3. _____ ft.

WELL'S STATIC WATER LEVEL ... 25 ... ft. below land surface measured on mo/day/yr 4-23-96

Pump test data: Well water was 53 ft. after 1 hours pumping 18 gpm

Est. Yield ... 18 ... gpm: Well water was _____ ft. after _____ hours pumping _____ gpm

Bore Hole Diameter ... 8 ... in. to ... 59 ... ft., and ... _____ in. to _____ ft.

WELL WATER TO BE USED AS:

1 Domestic	3 Feedlot	6 Oil field water supply	9 Dewatering	11 Injection well
2 Irrigation	4 Industrial	<u>7</u> Lawn and garden only	10 Monitoring well	12 Other (Specify below)

Was a chemical/bacteriological sample submitted to Department? Yes.....No.....X.....; If yes, mo/day/yr sample was submitted

Water Well Disinfected? Yes No

5 Wrought iron	8 Concrete tile	CASING JOINTS: Glued ☒ Clamped
6 Asbestos-Cement	9 Other (specify below)	Welded
7 Fiberglass		Threaded

Blank casing diameter 5 in. to 48 ft. Dia in. to ft. Dia in. to ft.
Casing height above land surface 12 in. weight 2.29 lbs./ft. Wall thickness or gauge No. 160

1 Steel	3 Stainless steel	5 Fiberglass	8 RMP (SR)	10 Other (specify)
2 Brass	4 Galvanized steel	6 Concrete tile	9 ABS	12 None used (open hole)

1 Continuous slot	3 Mill slot	6 Wire wrapped	9 Drilled holes
2 Louvered shutter	4 Key punched	7 Torch cut	10 Other (specify)

SCREEN-PERFORATED INTERVALS: From 48 ft. to 56 ft. From _____ ft. to _____ ft.
From _____ ft. to _____ ft. From _____ ft. to _____ ft.
GRAVEL PACK INTERVALS: From 23 ft. to 30 ft. From _____ ft. to _____ ft.
From 35 ft. to 59 ft. From _____ ft. to _____ ft.

6 GROUT MATERIAL: 1 Neat cement 2 Cement grout 3 Bentonite 4 Other
Grout intervals: From 3 ft. to 23 ft., From 30 ft. to 35 ft., From ft. to ft.

What is the nearest source of possible contamination:

1 Septic tank	4 Lateral lines	7 Pit privy	11 Fuel storage	15 Oil well/Gas well
2 Sewer lines	5 Cess pool	8 Sewage lagoon	12 Fertilizer storage	16 Other (specify below)
3 Watertight sewer lines	6 Seepage pit	9 Feedyard	13 Insecticide storage	

Direction from well?

FROM		TO		LITHOLOGIC LOG	FROM		TO		PLUGGING INTERVALS
------	--	----	--	----------------	------	--	----	--	--------------------

0	24	Rocky Br + Gr Clay
24	27	F-C Sand
27	50	Br + Gr Clay
50	55	F-M Sand
55	59	Shale

7 CONTRACTOR'S OR LANDOWNER'S CERTIFICATION: This water well was (1) constructed, (2) reconstructed, or (3) plugged under my jurisdiction and was completed on (mo/day/year) 4-23-96 and this record is true to the best of my knowledge and belief. Kansas Water Well Contractor's License No. 447 This Water Well Record was completed on (mo/day/yr) 5-16-96 under the business name of Miller Drilling by (signature) [Signature]