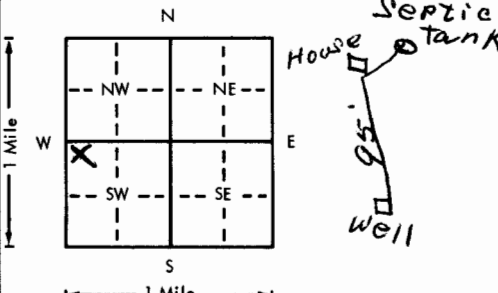


USE TYPEWRITER OR BALL
POINT PEN-PRESS FIRMLY,
PRINT CLEARLY.

WATER WELL RECORD
KSA 82a-1201-1215

Kansas Department of Health and
Environment-Division of Environment
(Water well Contractors)
Topeka, Kansas 66620

1. Location of well:		County <u>Moprherson</u>	Fraction <u>NW 1/4 NW 1/4 SW 1/4</u>	Section number <u>19</u>	Township number <u>T 20 S R 2</u>	Range number <u>2</u>
2. Distance and direction from nearest town or city: <u>2 E 1/2 N</u>		3. Owner of well: <u>Paul Zenger</u>		R.R. or street: <u>BR 1</u>		
Street address of well location if in city: <u>Elyria</u>		City, state, zip code: <u>Moprherson Mo. 67460</u>				
4. Locate with "X" in section below:		Sketch map:		6. Bore hole dia. <u>10</u> in. Completion date <u>11-18-75</u> Well depth <u>45</u> ft.		
				7. <input checked="" type="checkbox"/> Cable tool <input checked="" type="checkbox"/> Rotary <input type="checkbox"/> Driven <input type="checkbox"/> Dug <input type="checkbox"/> Hollow rod <input type="checkbox"/> Jetted <input type="checkbox"/> Bored <input type="checkbox"/> Reverse rotary		
5. Type and color of material		From		To		8. Use: <input checked="" type="checkbox"/> Domestic <input type="checkbox"/> Public supply <input type="checkbox"/> Industry <input checked="" type="checkbox"/> Irrigation <input type="checkbox"/> Air conditioning <input type="checkbox"/> Stock <input checked="" type="checkbox"/> Garden <input type="checkbox"/> Lawn <input type="checkbox"/> Oil field water <input type="checkbox"/> Other
<u>top soil</u>		<u>0</u>		<u>3</u>		9. Casing: Material <u>PVC</u> Height: Above or below Threaded <input type="checkbox"/> Welded <input type="checkbox"/> Surface <u>12</u> in. RMP <input type="checkbox"/> PVC <input checked="" type="checkbox"/> Weight <u>160</u> lbs./ft. Dia. <u>5</u> in. to <u>45</u> ft. depth Wall Thickness: inches or Dia. <u>5</u> in. to <u>45</u> ft. depth gage No. <u>0225</u>
<u>yellow clay</u>		<u>3</u>		<u>25</u>		10. Screen: Manufacturer's name <u>Pumpco Supply</u> Type <u>PVC</u> Dia. <u>5 1/2</u> Slot/gauze <u>1/16</u> Length <u>10'</u> Set between <u>35</u> ft. and <u>45</u> ft. ft. and <u>45</u> ft.
<u>Fine Sand</u>		<u>25</u>		<u>30</u>		Gravel pack? <input checked="" type="checkbox"/> Size range of material <u>4 to 30</u>
<u>Medium Sand</u>		<u>30</u>		<u>43</u>		11. Static water level: <u>25</u> ft. below land surface Date <u>11-18-75</u> mo./day/yr.
<u>Blue Shale</u>		<u>43</u>		<u>45</u>		12. Pumping level below land surfaces: ft. after <u> </u> hrs. pumping <u> </u> g.p.m. ft. after <u> </u> hrs. pumping <u> </u> g.p.m. Estimated maximum yield <u> </u> g.p.m.
						13. Water sample submitted: <u> </u> mo./day/yr. Yes <input type="checkbox"/> No <input checked="" type="checkbox"/> Date <u> </u>
						14. Well head completion: <u> </u> Pitless adapter <u> </u> inches above grade
						15. Well grouted? <input checked="" type="checkbox"/> With: <u> </u> Neat cement <u> </u> Bentonite <input checked="" type="checkbox"/> Concrete Depth: From <u>0</u> ft. to <u>10</u> ft.
						16. Nearest source of possible contamination: <u>Septic</u> ft. <u>95</u> Direction <u>well</u> Type <u>Tank</u> Well disinfected upon completion? <input checked="" type="checkbox"/> Yes <input type="checkbox"/> No
						17. Pump: <input checked="" type="checkbox"/> Not installed Manufacturer's name <u> </u> Model number <u> </u> HP <u> </u> Volts <u> </u> Length of drop pipe <u> </u> ft. capacity <u> </u> g.p.m. Type: <u> </u> Submersible <u> </u> Turbine <u> </u> Jet <u> </u> Reciprocating <u> </u> Centrifugal <u> </u> Other
						20. Water well contractor's certification: This well was drilled under my jurisdiction and this report is true to the best of my knowledge and belief. <u>Backhu</u> Drilling 180 Business name License No. <u> </u> Address <u>Topeka, Kansas</u> Signed <u>Paul Backhu</u> Date <u>12-16-75</u> Authorized representative
18. Elevation:		19. Remarks: <u>Well Pumped with</u> <u>wind mill</u> <u>Owner to run concrete slab</u> <u>around well 4'x4'x4'</u>				
Topography: <input type="checkbox"/> Hill <input type="checkbox"/> Slope <input checked="" type="checkbox"/> Upland <input type="checkbox"/> Valley						