

1 LOCATION OF WATER WELL: County: <u>Moppherson</u>	Fraction <u>NW 1/4 NW 1/4 NW 1/4</u>	Section Number <u>38</u>	Township Number T <u>20</u> S	Range Number R <u>2</u> E <u>W</u>
--	---	-----------------------------	----------------------------------	---------------------------------------

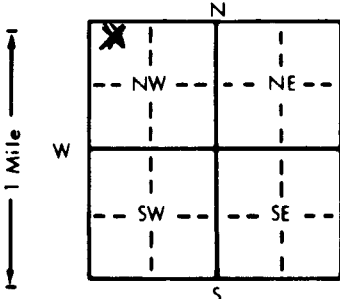
Distance and direction from nearest town or city street address of well if located within city?

6 S 34 W Galva2 WATER WELL OWNER: Ernest GoeringRR#, St. Address, Box #: RR4City, State, ZIP Code: Galva, KS.

Board of Agriculture, Division of Water Resources

Application Number:

3 LOCATE WELL'S LOCATION WITH AN "X" IN SECTION BOX:

4 DEPTH OF COMPLETED WELL: 76 ft. ELEVATION:Depth(s) Groundwater Encountered 1. 61 ft. 2. ft. 3. ft.WELL'S STATIC WATER LEVEL: 29 ft. below land surface measured on mo/day/yr 10-28-92

Pump test data: Well water was ft. after hours pumping gpm

Est. Yield 30 gpm. Well water was ft. after hours pumping gpmBore Hole Diameter: 9 in. to 76 ft., and in. to ft.

WELL WATER TO BE USED AS:

1 Domestic 3 Feedlot 6 Oil field water supply 9 Dewatering 12 Other (Specify below)

2 Irrigation 4 Industrial 7 Lawn and garden only 10 Monitoring well

Was a chemical/bacteriological sample submitted to Department? Yes No Y; If yes, mo/day/yr sample was submittedWater Well Disinfected? Yes X No

5 TYPE OF BLANK CASING USED:

1 Steel 3 RMP (SR)

2 PVC 4 ABS

5 Wrought iron

6 Asbestos-Cement

7 Fiberglass

8 Concrete tile

9 Other (specify below)

CASING JOINTS: Glued X Clamped

Welded

Threaded

Blank casing diameter: 5 in. to 60 ft., Dia. in. to ft., Dia. in. to ft.Casing height above land surface: 12 in., weight CLASS 160 lbs./ft. Wall thickness or gauge No. 2/4

TYPE OF SCREEN OR PERFORATION MATERIAL:

1 Steel 3 Stainless steel

2 Brass 4 Galvanized steel

5 Fiberglass

6 Concrete tile

7 PVC

8 RMP (SR)

9 ABS

10 Asbestos-cement

11 Other (specify)

12 None used (open hole)

SCREEN OR PERFORATION OPENINGS ARE:

1 Continuous slot 3 Mill slot

2 Louvered shutter 4 Key punched

5 Gauzed wrapped

6 Wire wrapped

7 Torch cut

8 Saw cut

9 Drilled holes

10 Other (specify)

11 None (open hole)

SCREEN-PERFORATED INTERVALS: From 60 ft. to 76 ft., From ft. to ft., From ft. to ft.

From ft. to ft., From ft. to ft., From ft. to ft.

GRAVEL PACK INTERVALS: From 22 ft. to 76 ft., From ft. to ft., From ft. to ft.

From ft. to ft., From ft. to ft., From ft. to ft.

6 GROUT MATERIAL:

1 Neat cement

2 Cement grout

3 Bentonite

4 Other

Grout Intervals: From 0 ft. to 22 ft., From ft. to ft., From ft. to ft., From ft. to ft.

What is the nearest source of possible contamination:

1 Septic tank

4 Lateral lines

7 Pit privy

10 Livestock pens

14 Abandoned water well

2 Sewer lines

5 Cess pool

8 Sewage lagoon

11 Fuel storage

15 Oil well/Gas well

3 Watertight sewer lines

6 Seepage pit

9 Feedyard

12 Fertilizer storage

16 Other (specify below)

13 Insecticide storage

Direction from well? WHow many feet? 100 +

FROM	TO	LITHOLOGIC LOG	FROM	TO	PLUGGING INTERVALS
<u>0</u>	<u>22</u>	<u>Clay</u>			
<u>22</u>	<u>31</u>	<u>fine Sand</u>			
<u>31</u>	<u>42</u>	<u>Yellow Clay</u>			
<u>42</u>	<u>51</u>	<u>fine Sand</u>			
<u>51</u>	<u>61</u>	<u>Yellow Clay</u>			
<u>61</u>	<u>74</u>	<u>medium Sand</u>			
<u>74</u>	<u>76</u>	<u>Blue Shale</u>			

7 CONTRACTOR'S OR LANDOWNER'S CERTIFICATION: This water well was (1) constructed, (2) reconstructed, or (3) plugged under my jurisdiction and was completed on (mo/day/year) 10-28-92 and this record is true to the best of my knowledge and belief. KansasWater Well Contractor's License No. 780This Water Well Record was completed on (mo/day/yr) 11-10-92under the business name of Backhus Drillingby (signature) Paul H. Backhus

INSTRUCTIONS: Use typewriter or ball point pen. PLEASE PRESS FIRMLY and PRINT clearly. Please fill in blanks, underline or circle the correct answers. Send top three copies to Kansas Department of Health and Environment, Bureau of Water, Topeka, Kansas 66620-0001. Telephone: 913-296-5545. Send one to WATER WELL OWNER and retain one for your records.