


|                           |                             |                |                 |                        |
|---------------------------|-----------------------------|----------------|-----------------|------------------------|
| 1 LOCATION OF WATER WELL: | Fraction                    | Section Number | Township Number | Range Number           |
| County: <u>McPherson</u>  | <u>NW 1/4 NW 1/4 NW 1/4</u> | <u>29</u>      | T <u>20</u> S   | R <u>2</u> E <u>20</u> |

Distance and direction from nearest town or city street address of well if located within city?

3 mi E of Elyria

|                           |                            |   |
|---------------------------|----------------------------|---|
| 2 WATER WELL OWNER:       | <u>Dwane Swick</u>         | Board of Agriculture, Division of Water Resources |
| RR#, St. Address, Box # : | <u>Rt 1</u>                | Application Number:                               |
| City, State, ZIP Code :   | <u>McPherson, KS 67460</u> |   |

|  |   |
|--|---|
| 3 LOCATE WELL'S LOCATION WITH AN "X" IN SECTION BOX: | 4 DEPTH OF COMPLETED WELL: <u>67</u> ft. ELEVATION: |
|--|---|

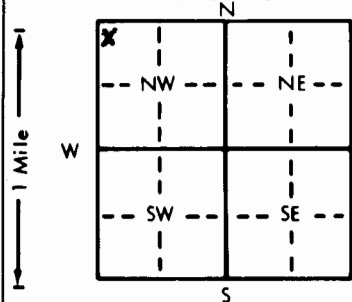

Depth(s) Groundwater Encountered 1. ft. 2. ft. 3. ft.


WELL WATER TO BE USED AS: 5 Public water supply 8 Air conditioning 11 Injection well

1 Domestic 3 Feedlot 6 Oil field water supply 9 Dewatering 12 Other (Specify below)

2 Irrigation 4 Industrial 7 Lawn and garden only 10 Observation well

Was a chemical/bacteriological sample submitted to Department? Yes No; If yes, mo/day/yr sample was submitted Water Well Disinfected? Yes Yes No

|                              |                |                   |   |
|------------------------------|----------------|-------------------|---|
| 5 TYPE OF BLANK CASING USED: | 5 Wrought iron | 8 Concrete tile   | CASING JOINTS: Glued <u>Yes</u> Clamped |
| 1 Steel                      | 3 RMP (SR)     | 6 Asbestos-Cement | 9 Other (specify below)                 |
| <u>2</u> PVC                 | 4 ABS          | 7 Fiberglass      | Welded                                  |
|                              |                |                   | Threaded                                |


1 Steel 3 Stainless steel 5 Fiberglass 8 RMP (SR) 11 Other (specify)

2 Brass 4 Galvanized steel 6 Concrete tile 9 ABS 12 None used (open hole)

SCREEN OR PERFORATION OPENINGS ARE: 5 Gauzed wrapped 8 Saw cut 11 None (open hole)

1 Continuous slot 3 Mill slot 6 Wire wrapped 9 Drilled holes

2 Louvered shutter 4 Key punched 7 Torch cut 10 Other (specify)


|  |                      |                |             |         |
|--|----------------------|----------------|-------------|---------|
| 6 GROUT MATERIAL:  | <u>1</u> Neat cement | 2 Cement grout | 3 Bentonite | 4 Other |

What is the nearest source of possible contamination: 10 Livestock pens 14 Abandoned water well

1 Septic tank 4 Lateral lines 7 Pit privy 11 Fuel storage 15 Oil well/Gas well

2 Sewer lines 5 Cess pool 8 Sewage lagoon 12 Fertilizer storage 16 Other (specify below)

3 Watertight sewer lines 6 Seepage pit 9 Feedyard 13 Insecticide storage

Direction from well? SE How many feet? 80

| FROM | TO | LITHOLOGIC LOG       | FROM | TO | LITHOLOGIC LOG |
|------|----|----------------------|------|----|----------------|
| 0    | 3  | BK Top Soil          |      |    |                |
| 3    | 6  | OK Gr Clay           |      |    |                |
| 6    | 22 | 2 Gr Clay            |      |    |                |
| 22   | 33 | Br + Gr Clay         |      |    |                |
| 33   | 36 | Gr Clay              |      |    |                |
| 36   | 38 | Br + Gr + BK Clay    |      |    |                |
| 38   | 39 | F Sand               |      |    |                |
| 39   | 50 | Br + Gr Clay         |      |    |                |
| 50   | 55 | Fine Sand            |      |    |                |
| 55   | 59 | Gr Clay              |      |    |                |
| 59   | 64 | F-C Sand - 5m Gravel |      |    |                |
| 64   | 70 | Br + Gr Clay         |      |    |                |

|   |
|---|
| 7 CONTRACTOR'S OR LANDOWNER'S CERTIFICATION: This water well was <u>1</u> constructed, (2) reconstructed, or (3) plugged under my jurisdiction and was completed on (mo/day/year) <u>9-15-84</u> and this record is true to the best of my knowledge and belief. Kansas |
|---|

Water Well Contractor's License No. 447 This Water Well Record was completed on (mo/day/yr) 1-29-85under the business name of Miller Drilling by (signature) G. Miller

INSTRUCTIONS: Use typewriter or ball point pen, PLEASE PRESS FIRMLY and PRINT clearly. Please fill in blanks, underline or circle the correct answers. Send top three copies to Kansas Department of Health and Environment, Division of Environment, Environmental Geology Section, Topeka, KS 66620. Send one to WATER WELL OWNER and retain one for your records.