USE TYPEWRITER OR BALL POINT PEN-PRESS FIRMLY, PRINT CLEARLY.

WATER WELL RECORD
KSA 82a-1201-1215

Kansas Department of Health and Environment-Division of Environment
(Water well Contractors)
Topeka, Kansas 66620

1. Location of well:	County	Fraction	Section number	Township number	Range number
	PAWNEE	NW 1/4 NE 1/4 NW 1/4	31	T 20 S	R 20 E (W)

2. Distance and direction from nearest town or city: 6MI. NORTH 2 MI. WEST FROM BURDETT
Street address of well location if in city:

3. Owner of well: STEVE MILLER
R.R. or street:
City, state, zip code: BURDETT, KANSAS

4. Locate with "X" in section below: Sketch map:

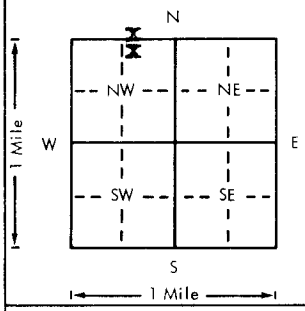

6. Bore hole dia. 8 in. Completion date
Well depth 190 ft. 4 SEPT 1978

7. __ Cable tool X Rotary __ Driven __ Dug
__ Hollow rod __ Jetted __ Bored __ Reverse rotary

8. Use: __ Domestic __ Public supply __ Industry
__ Irrigation __ Air conditioning X Stock
__ Lawn __ Oil field water __ Other

9. Casing: Material
Threaded ___ Welded ___
RMP ___ PVC X
Dia. 5 in. to 170 ft. depth
Dia. ___ in. to ___ ft. depth
Height: Above or Below Surface 12 in.
Weight ___ lbs./ft.
Wall Thickness: inches or gage No. SCH 40

5. Type and color of material	From	To
topsoil	0	3
tan clay	3	6
limestone and clachie	6	17
limestone rock (broken)	17	19
alternating layers of black and grey shale	19	86
multi-colored clays or shales	86	165
sandstone	165	187
red clay (hard)	187	205
(Use a second sheet if needed)		

10. Screen: Manufacturer's name MODERN PIPE
Type PVC Dia. 5"
Slot/gauze 1/16 Length 20'
Set between 170 ft. and 190 ft.
___ ft. and ___ ft.
Gravel pack? yes Size range of material #1

11. Static water level: mo./day/yr.
109 ft. below land surface Date 9/3/78

12. Pumping level below land surfaces:
114 ft. after 2 hrs. pumping 9 g.p.m.
___ ft. after ___ hrs. pumping ___ g.p.m.
Estimated maximum yield 40 Plus ?? g.p.m.

13. Water sample submitted: mo./day/yr.
__ Yes X No Date

14. Well head completion:
__ Pitless adapter 12 Inches above grade

15. Well grouted? yes
With: X Neat cement ___ Bentonite ___ Concrete
Depth: From 0 ft. to 10 ft.

16. Nearest source of possible contamination:
ft. RAVINE direction 40 SW Type RAVINE
Well disinfected upon completion? X Yes ___ No

17. Pump: WINDMILL 2" cylinder __ Not installed
Manufacturer's name
Model number ___ HP ___ Volts ___
Length of drop pipe 126 ft. capacity 2 g.p.m.
Type:
__ Submersible __ Turbine
__ Jet __ Reciprocating
__ Centrifugal __ Other

18. Elevation:
Topography:
__ Hill
__ Slope
X Upland
__ Valley

19. Remarks:

20. Water well contractor's certification:
This well was drilled under my jurisdiction and this report is true to the best of my knowledge and belief.
DEAN WATERHOUSE DRILLING 245
Business name License No.
Address HANSTON, KANSAS
Signed Dean Waterhouse Date 15 Oct 78
Authorized representative

T 20 R 20 (W) E Sec 31 1/4 NW 1/4 NE 1/4 NW

Forward the white, blue and pink copies to the Department of Health and Environment

Form WWC-5

MI-1023