


1 LOCATION OF WATER WELL: Fraction NE 1/4 NW 1/4 NE 1/4 Section Number 33 Township Number T 20 S Range Number R 20 EW
 County: Pawnee

Distance and direction from nearest town or city street address of well if located within city? 5 N, 1/2 W Burdett

2 WATER WELL OWNER: Steve Miller
 RR#, St. Address, Box # : Burdett, Ks. 67523 Board of Agriculture, Division of Water Resources
 City, State, ZIP Code : Application Number:

3 LOCATE WELL'S LOCATION WITH AN "X" IN SECTION BOX:

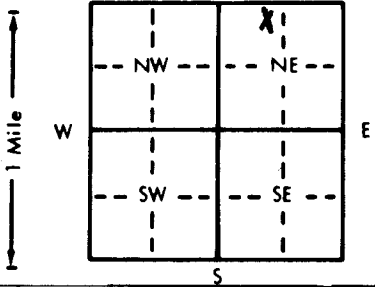

4 DEPTH OF COMPLETED WELL: 80 ft. ELEVATION:
 Depth(s) Groundwater Encountered 1. 38 ft. 2. ft. 3. ft.
 WELL'S STATIC WATER LEVEL: 38 ft. below land surface measured on mo/day/yr 2-14-84
 Pump test data: Well water was ft. after hours pumping gpm
 Est. Yield NA gpm: Well water was ft. after hours pumping gpm
 Bore Hole Diameter: 1.0 in. to 8.0 ft., and in. to ft.
 WELL WATER TO BE USED AS:
 Domestic 3 Feedlot 6 Oil field water supply 9 Dewatering 12 Other (Specify below) Stock
 2 Irrigation 4 Industrial 7 Lawn and garden only 10 Observation well
 Was a chemical/bacteriological sample submitted to Department? Yes No X; If yes, mo/day/yr sample was submitted
 Water Well Disinfected? Yes HTH No

5 TYPE OF BLANK CASING USED:
 1 Steel 3 RMP (SR) 5 Wrought iron 8 Concrete tile CASING JOINTS: X Glued Clamped
 2 PVC 4 ABS 6 Asbestos-Cement 9 Other (specify below) Welded
 7 Fiberglass Threaded

Blank casing diameter 5 in. to 6.0 ft., Dia in. to ft., Dia in. to ft.
 Casing height above land surface 1.8 in., weight lbs./ft. Wall thickness or gauge No. 258

TYPE OF SCREEN OR PERFORATION MATERIAL:
 1 Steel 3 Stainless steel 5 Fiberglass 7 PVC 10 Asbestos-cement
 2 Brass 4 Galvanized steel 6 Concrete tile 8 RMP (SR) 11 Other (specify)
 12 None used (open hole)

SCREEN OR PERFORATION OPENINGS ARE:
 1 Continuous slot 3 Mill slot 5 Gauzed wrapped 8 Saw cut 11 None (open hole)
 2 Louvered shutter 4 Key punched 6 Wire wrapped 9 Drilled holes
 7 Torch cut 10 Other (specify)

SCREEN-PERFORATED INTERVALS: From 60 ft. to 80 ft., From ft. to ft.
 From ft. to ft., From ft. to ft.
 GRAVEL PACK INTERVALS: From 10 ft. to 80 ft., From ft. to ft.
 From ft. to ft., From ft. to ft.

6 GROUT MATERIAL: 1 Neat cement 2 Cement grout 3 Bentonite 4 Other
 Grout intervals: From 0 ft. to 1.0 ft., From ft. to ft., From ft. to ft.

What is the nearest source of possible contamination:
 Septic tank 4 Lateral lines 7 Pit privy 10 Livestock pens 14 Abandoned water well
 2 Sewer lines 5 Cess pool 8 Sewage lagoon 11 Fuel storage 15 Oil well/Gas well
 3 Watertight sewer lines 6 Seepage pit 9 Feedyard 12 Fertilizer storage 16 Other (specify below)
 13 Insecticide storage
 Direction from well? South How many feet? 110'

FROM	TO	LITHOLOGIC LOG	FROM	TO	LITHOLOGIC LOG
0	3	<u>01</u> Dark top soil			
3	47	Tan clay			
47	64	<u>04</u> Tan sandy clay			
64	80	<u>07</u> Sand and gravel w/clay mixed & broken rock			
80		<u>04</u> Tan sandy clay			

7 CONTRACTOR'S OR LANDOWNER'S CERTIFICATION: This water well was (1) constructed, (2) reconstructed, or (3) plugged under my jurisdiction and was completed on (mo/day/year) 2-14-84 and this record is true to the best of my knowledge and belief. Kansas Water Well Contractor's License No. 134 This Water Well Record was completed on (mo/day/yr) 3-1-84 under the business name of Rosencrantz-Bemis Ent. by (signature) Lora Dodson

INSTRUCTIONS: Use typewriter or ball point pen, PLEASE PRESS FIRMLY and PRINT clearly. Please fill in blanks, underline or circle the correct answers. Send top three copies to Kansas Department of Health and Environment, Division of Environment, Environmental Geology Section, Topeka, KS 66620. Send one to WATER WELL OWNER and retain one for your records.

OFFICE USE ONLY T 20 R 20 SEC 33 NE 1/4 NW 1/4 NE 1/4

D