

USE TYPEWRITER OR BALL POINT PEN-PRESS FIRMLY, PRINT CLEARLY.

T R EW sec 1/4 1/4 1/4 No.

WATER WELL RECORD
KST 82-1201-1215
ADE
SW SE NE


Henry M

Kansas State Dept. Of Health
(Water Well Contractors)
Forbes-Bldg. 740
Topeka, Kansas 66620

1 Location of well:	County: JESS	Township name: HIGHPOINT	Fraction: NE 1/4	Section number: 32	Town number: 20	Range number: 21
---------------------	---------------------	---------------------------------	-------------------------	---------------------------	------------------------	-------------------------

Distance and direction from nearest town or city: **11 SOUTH EAST**
1 SOUTH EAST 1/2 SOUTH 1/4 WEST
 Street address of well location if in city: **OF BAZINE**

3 Owner of well: **HENRY BELTZ**
 Address: **BAZINE KANSAS 67516**

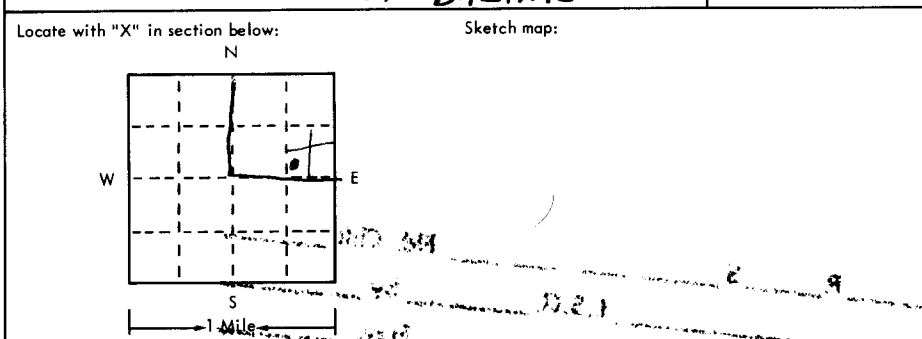

4 Well depth: **305** ft. Date of completion: **26-JUL**
 Well diameter: **8** in.

5 Cable tool Rotary Driven Dug
 Hollow rod Jetted Bored Reverse rotary

6 Use: Domestic Public supply Industry
 Irrigation Air conditioning Commercial
 Test well

7 Casing: Material: **PLASTIC** Height: above/below
 Threaded Welded Surface **4** in.
 Dia. **3 3/4** in. Weight: **20** lbs/ft
3 in. to **39** ft. depth Drive shoe? Yes No
9 1/2 in. to ___ ft. depth

2	Type and color of material	From	To
	YELLOW CLAY	0	28
	BLACK SHALE	28	120
	GRAY STICKY CLAY OR SHALE	120	140
	BLUE SOFT CLAY	140	155
	STRIP FINE SANDSTONE	155	158
	MULTI-COLORED CLAYS & SHELLS	158	230
	LIGHT COLORED CLAY-GRAY	230	280
	RED CLAY	280	290
	GOOD SANDSTONE	290	305
	RED CLAY	305	312
	BROCK 28'		
	CRETACEOUS WELL		

8 Screen: Manufacturer: **JESSE + LOWELL**
 Type: **STYRENE** Dia. **5"**
 Slot/gauze: **1/4"** Length: **10'**
 Set between: **2 1/2** ft. and **30** ft.

Fittings: Gravel pack Yes No Size range of material: **4 L**

9 Static water level: **90** ft. below land surface Date: **26-JUL**

10 Pumping level below land surfaces:
 ___ ft. after ___ hrs. pumping ___ g.p.m.
 ___ ft. after ___ hrs. pumping ___ g.p.m.
 Estimated maximum yield: ___ g.p.m.

11 Water sample submitted:
 Yes No Date: ___

12 Well head completion:
 Pitless adapter **14** inches above grade

13 Well grouted? Yes No
 Neat cement Bentonite
 Depth: From **3** ft. to **10** ft.

14 Nearest source of possible contamination: **80** ft. Direction: **NE** Type: **TANK**
 Well disinfected upon completion? Yes No

15 Pump: Not installed
 Manufacturer's name: **MEYERES**
 Model number: ___ HP: **1/2** Volts: **115V**
 Length of drop pipe: **168** ft. capacity: **12** g.m.p.
 Type: Submersible Turbine
 Jet Reciprocating
 Centrifugal Other

16 Remarks: elevation

Topography: Hill Slope Upland Valley

Customer to run concrete slab around well 1998
1990

17 Water well contractor's certification:
 This well was drilled under my jurisdiction and this report is true to the best of my knowledge and belief.

Dean WATERHOSE PRILLMAN #13
 Business name: **WATERHOSE PRILLMAN** License No. **13**
 Address: **WATERHOSE PRILLMAN**
 Signed: *Dean Waterhose* Date: **2-3-75**
 Authorized representative