USE TYPEWRITER OR BALL POINT PEN-PRESS FIRMLY, PRINT CLEARLY.

20	22	W	27	SW	SW	SW
T	R	EW	sec	1/4	1/4	1/4 No.

WATER WELL RECORD
KSA 82a-1201-1215

Kansas State Dept. Of Health
(Water Well Contractors)
Farbes-Bldg. 740
Topeka, Kansas 66620

1 Location of well:	County	Township name	Fraction	Section number	Town number	Range number
	NESS	HIGH POINT	SW SW SW 1/4	27	20	22

Distance and direction from nearest town or city: 10 MI. N. 1 3/4 W FROM HANSTON KS

Street address of well location if in city:

3 Owner of well: BARRICKLOW PARTNERSHIP

Address: C/O MRS. CARL HOLMES NESS CITY

Locate with "X" in section below: Sketch map:

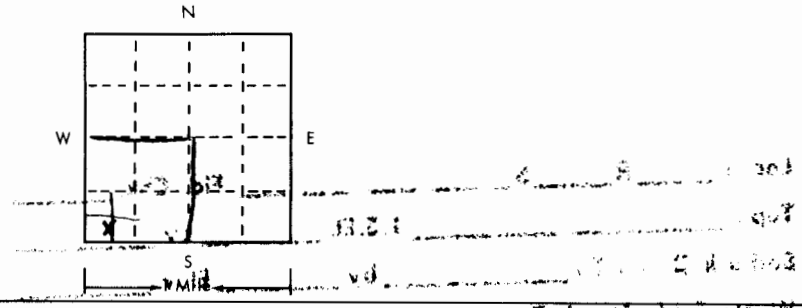

4 Well depth: 77 ft. Date of completion 30 SEPT
Well diameter 5 in.

5 ☐ Cable tool ☒ Rotary ☐ Driven ☐ Dug
☐ Hollow rod ☐ Jetted ☐ Bored ☐ Reverse rotary

6 Use: ☒ Domestic ☐ Public supply ☐ Industry
☐ Irrigation ☐ Air conditioning ☐ Commercial
☐ Test well ☐

7 Casing: Material STYRENE Height above/below
Threaded ☐ Welded ☐ Surface in. 12
Diam. 5 in. to 67 ft. depth Weight 250 WALL
in. to ft. depth Drive shoe? ☐ Yes ☒ No

2

Type and color of material	From	To
TOPSOIL	0	4
BROWN CLAY	4	15
TAN CLAY	15	18
FINE SAND	18	38
CLAY LIGHT + TOUGH	38	40
SAND - MEDIUM TO FINE	40	76
BLUE CLAY	76	78
BLUE SHALE	78	80
BROK 76		
41		
35 sat thick		
Alluvium		
(use o second sheet if needed)		

8 Screen:
Manufacturer J+L
Type STYRENE Dia. 5"
Slot/gauze 40 Length 10'
Set between 67 ft. and 77 ft.
Fittings:
Grovel pack ☒ Yes ☐ No Size range of material 1/8 - 1/4

9 Static water level:
41 ft. below land surface Date 30-SEPT

10 Pumping level below land surfaces:
ft. after hrs. pumping g.p.m.
ft. after hrs. pumping g.p.m.
Estimated maximum yield g.p.m.

11 Water sample submitted:
☐ Yes ☒ No Date

12 Well head completion:
☒ Pitless adapter 12 Inches above grade

13 Well grouted? ☒ Yes ☐ No
☒ Neat cement ☐ Bentonite ☐
Depth: From 3 ft. to 15 ft.

14 Nearest source of possible contamination:
ft. 250 Direction NE Type OIL WELL
Well disinfected upon completion? ☒ Yes ☐ No

15 Pump: ☐ Not installed
Manufacturer's name TRW
Model number 9D PUST HP 1/2 Volts 230
Length of drop pipe 63 ft. capacity 12 g.m.p.
Type:
☒ Submersible ☐ Turbine
☐ Jet ☐ Reciprocating
☐ Certrifugal ☐ Other

16 Remarks: elevation TENANT TO RUN SLAB

2173
76
2097

BROK 76
41
35 sat thick

Topography:
☐ Hill
☐ Slope
☐ Upland
☒ Valley

17 Water well contractor's certification:
This well was drilled under my jurisdiction and this report is true to the best of my knowledge and belief.
Business name DEAN WATERHOUSE DRLG License No. 244
Address HANSTON KS
Signed Authorized representative Date 3-OCT

20 22 W 27 SW SW SW

Forward the white, blue and pink copies to the Kansas State Dept. Of Health.

Form WWC-5

677-H