

**WATER WELL PLUGGING RECORD Form WWC-5P**

KSA 82a-1212

ID NO.

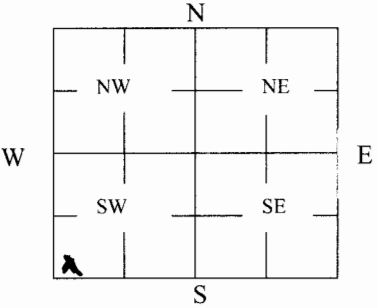
NS- 027

<b>1 LOCATION OF WATER WELL:</b> County: <u>Ness</u>	Fraction <u>SW ¼ SW ¼ SW ¼</u>	Section Number <u>20</u>	Township Number <u>20</u>	Range Number <u>22</u> <del>E/W</del>
---	-----------------------------------	-----------------------------	------------------------------	--

Distance and direction from nearest town or city street address of well if located within city?

10 South, 5 West of Bazine

<b>2 WATER WELL OWNER:</b> Brent Whitley 23830 30 Road RR#, St. Address, Box #: Ness City, Ks. 67560 City, State ZIP Code:	<b>Global Positioning Systems</b> (decimal degrees, min. of 4 digits) Latitude: _____ Longitude: _____ Elevation: _____ Datum: _____ Data Collection Method: _____
---	---

<b>3 MARK WELL'S LOCATION WITH AN "X" IN SECTION BOX:</b> 	<b>4 DEPTH OF WELL</b> <u>80</u> ft. WELL'S STATIC WATER LEVEL <u>36</u> ft. WELL WAS USED AS: 1 Domestic                      5 Public Water Supply                      9 Dewatering 2 <u>Irrigation</u> 6 Oil Field Water Supply                      10 Monitoring 3 Feedlot                          7 Domestic (Lawn & Garden)                      11 Injection Well 4 Industrial                      8 Air Conditioning                          12 Other _____ Was a chemical/bacteriological sample submitted to Department? Yes _____ No <u>X</u>
--	--

**5 TYPE OF BLANK CASING USED:**  
 1 Steel      3 RMP (SR)      5 Wrought      7 Fiberglass      9 Other (Specify below) \_\_\_\_\_  
 2 PVC      4 ABS      6 Asbestos-Cement      8 Concrete Tile

Blank casing diameter 16 in. Was casing pulled? Yes \_\_\_\_\_ No X If yes, how much \_\_\_\_\_  
 Casing height above or below land surface 36 in.

**6 GROUT PLUG MATERIAL:**      1 Neat cement      2 Cement grout      3 Bentonite      4 Other \_\_\_\_\_

Grout Plug Intervals: From 36 ft. to 19 ft., From \_\_\_\_\_ ft. to \_\_\_\_\_ ft., From \_\_\_\_\_ to \_\_\_\_\_ ft.

What is the nearest source of possible contamination:  
 1 Septic tank      6 Seepage pit      11 Fuel Storage      16 Other (specify below) \_\_\_\_\_  
 2 Sewer lines      7 Pit privy      12 Fertilizer storage  
 3 Watertight sewer lines      8 Sewage lagoon      13 Insecticide storage  
 4 Lateral lines      9 Feedyard      14 Abandoned water well      Direction from well? Southeast  
 5 Cess pool      10 Livestock pens      15 Oil well/Gas well      How many feet? 1170

FROM	TO	PLUGGING MATERIALS	FROM	TO	PLUGGING MATERIALS
80	36	Chlorinated gravel			
36	19	Cement			
19	3	Clay			
3	0	Top soil			

**7 CONTRACTOR'S OR LANDOWNER'S CERTIFICATION:** This water well was plugged under my jurisdiction and was completed on (mo/day/year) 3-31-09 and this record is true to the best of my knowledge and belief. Kansas Water Well Contractor's License No. 134. This Water Well Record was completed on (mo/day/year) 4-30-09 under the business name of Rosencrantz- Bemis by (signature) [Signature]

**INSTRUCTIONS:** Use typewriter or ballpoint pen. Please press firmly and print clearly. Please fill in blanks, underline or circle the correct answers. Send top three copies to Kansas Department of Health and Environment, Bureau of Water, Geology Section, 1000 SW Jackson St., Ste. 420, Topeka, Kansas 66612-1367. Telephone: 785/296-5522. Send one to Water Well Owner and retain one for your records. Visit us at <http://www.kdheks.gov/geo/waterwells>.