

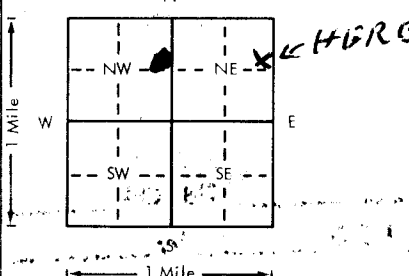
USE TYPEWRITER OR BALL
POINT PEN-PRESS FIRMLY,
PRINT CLEARLY.

WATER WELL RECORD
KSA 82a-1201-1215

Kansas Department of Health and
Environment-Division of Environment
(Water well Contractors)
Topeka, Kansas 66620

AAD

miss city re

1. Location of well:		County NESS	Fraction SE 1/4 NE 1/4 NE 1/4	Section number 33	Township number T 20 S R 22 E/W	Range number
2. Distance and direction from nearest town or city: 9 mi. north 1 3/4 mi. west 3/4 north from Hanston			3. Owner of well: Dean Barricklow Street address of well location if in city: R.R City, state, zip code: Ness City, Kansas 67560			
4. Locate with "X" in section below:		Sketch map:		6. Bore hole dia. 8 in. Completion date 3/20/79 Well depth 108 ft.		
				7. <input checked="" type="checkbox"/> Cable tool <input checked="" type="checkbox"/> Rotary <input type="checkbox"/> Driven <input type="checkbox"/> Dug <input type="checkbox"/> Hollow rod <input type="checkbox"/> Jetted <input type="checkbox"/> Bored <input type="checkbox"/> Reverse rotary		
5. Type and color of material		From	To	8. Use: <input checked="" type="checkbox"/> Domestic <input type="checkbox"/> Public supply <input type="checkbox"/> Industry <input type="checkbox"/> Irrigation <input type="checkbox"/> Air conditioning <input type="checkbox"/> Stock <input type="checkbox"/> Lawn <input type="checkbox"/> Oil field water <input type="checkbox"/> Other		
tan clay		0	16	9. Casing: Material <input type="checkbox"/> Threaded <input type="checkbox"/> Welded <input type="checkbox"/> Surface 12 in. RMP <input type="checkbox"/> PVC <input checked="" type="checkbox"/> Weight <input type="checkbox"/> lbs./ft. Dia. 5 in. to 58 ft. depth Wall Thickness: inches or Dia. 58 in. to 98 ft. depth gage No. 200		
fine dry sand		16	24	10. Screen: Manufacturer's name Jet stream Type PVC Dia. 5" Slot/gauze 1/16 Length 20' Set between 58 ft. and 68 ft. 98 ft. and 108 ft.		
tan clay		24	28	Gravel pack? Yes Size range of material #1		
good sand fine at first getting better with depth		28	62	11. Static water level: 44 ft. below land surface Date 3/17/79		
tan clay (soft)		62	99	12. Pumping level below land surfaces: 52 ft. after 4 hrs. pumping 42 g.p.m. ft. after 1 hrs. pumping 42 g.p.m. Estimated maximum yield 125-150 g.p.m.		
sand and gravel good and loose		99	106	13. Water sample submitted: Yes <input checked="" type="checkbox"/> No <input type="checkbox"/> Date 3/17/79		
blue shale		106	110	14. Well head completion: <input checked="" type="checkbox"/> Pitless adapter 12 inches above grade		
BRICK 106				15. Well grouted? Yes With: <input checked="" type="checkbox"/> Neat cement <input type="checkbox"/> Bentonite <input type="checkbox"/> Concrete Depth: From -4 ft. to -15 ft.		
52				16. Nearest source of possible contamination: underground ft. 50 Direction west Type gas tank		
54				Well disinfected upon completion? <input checked="" type="checkbox"/> Yes <input type="checkbox"/> No		
in Alluvium				17. Pump: <input type="checkbox"/> Not installed Manufacturer's name Reda Model number 9D9P051 HP 1 Volts 230 Length of drop pipe 73 ft. capacity 9 g.p.m. Type: <input checked="" type="checkbox"/> Submersible <input type="checkbox"/> Turbine <input type="checkbox"/> Jet <input type="checkbox"/> Reciprocating <input type="checkbox"/> Centrifugal <input type="checkbox"/> Other		
18. Elevation:		19. Remarks:		20. Water well contractor's certification:		
Topography: <input type="checkbox"/> Hill <input type="checkbox"/> Slope <input type="checkbox"/> Upland <input checked="" type="checkbox"/> Valley		Mr. barricklow will run slab around casing after ground settles. He knows this is regulateen. Signed: Dean Barricklow		This well was drilled under my jurisdiction and this report is true to the best of my knowledge and belief. Dean Waterhouse Drilling 243 Business name Hanston, Kansas License No. 3/24/79 Address Hanston, Kansas Signed Dean Waterhouse Date 3/24/79 Authorized representative		

Forward the white, blue and pink copies to the Department of Health and Environment

Form WWC-5