

WATER WELL PLUGGING RECORD Form WWC-5P KSA 82a-1212 ID NO.


1 LOCATION OF WATER WELL: County: Ness Fraction 1/4 1/4 CW 1/4 NE 1/4 Section Number 30 Township Number T 20 S Range Number 22 [] E [x] W

Street/Rural Address of Well Location; if unknown, distance & direction from nearest town or intersection: If at owner's address, check here [] 10 3/4 South, 5 1/4 East of Ness City

Global Positioning Systems (GPS) information: Latitude: (in decimal degrees) Longitude: (in decimal degrees) Elevation: Datum: [] WGS84, [] NAD83, [] NAD27 Collection Method: [] GPS unit (Make/Model: [] Digital Map/Photo, [] Topographic Map, [] Land Survey Est. Accuracy: [] < 3 m, [] 3-5 m, [] 5-15 m, [] > 15 m

2 WATER WELL OWNER: Brent Whitley RR#, St. Address, Box #: 23830 30 Road City, State ZIP Code: Ness City, Ks. 67560

3 MARK WELL'S LOCATION WITH AN "X" IN SECTION BOX:

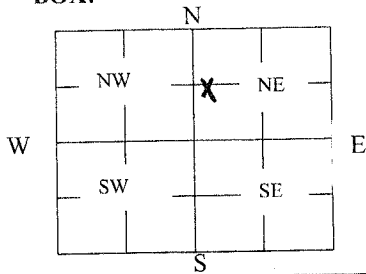

4 DEPTH OF WELL 78 ft.

WELL'S STATIC WATER LEVEL 40 ft

WELL WAS USED AS:

- [x] Irrigation [] Domestic [] Public Water Supply [] Dewatering [] Oil Field Water Supply [] Monitoring [] Feedlot [] Domestic (Lawn & Garden) [] Injection Well [] Industrial [] Air Conditioning [] Other

Was a chemical/bacteriological sample submitted to Department? Yes [] No [x]

5 TYPE OF BLANK CASING USED:

- [x] Steel [] RMP (SR) [] Wrought [] Fiberglass [] Other (Specify below) [] PVC [] ABS [] Asbestos-Cement [] Concrete Tile

Blank casing diameter 16 in. Was casing pulled? Yes [] No [x] If yes, how much Casing height above or below land surface 60 in.

6 GROUT PLUG MATERIAL:

- [x] Neat cement [] Cement grout [x] Bentonite [] Other

Grout Plug Intervals: From 20 ft. to 5 ft., From 40 ft. to 20 ft., From to

What is the nearest source of possible contamination:

- [] Septic tank [] Seepage pit [] Fuel Storage [x] Other (specify below) [] Sewer lines [] Pit privy [] Fertilizer storage [] None [] Watertight sewer lines [] Sewage lagoon [] Insecticide storage [] Lateral lines [] Feedyard [] Abandoned water well [] Direction from well? [] Cess pool [] Livestock pens [] Oil well/Gas well [] How many feet?

Table with 6 columns: FROM, TO, PLUGGING MATERIALS, FROM, TO, PLUGGING MATERIALS. Rows show intervals from 78 to 40 ft (Chlorinated gravel), 40 to 20 ft (Bentonite), 20 to 5 ft (Cement), and 5 to 0 ft (Top soil).

7 CONTRACTOR'S OR LANDOWNER'S CERTIFICATION: This water well was plugged under my jurisdiction and was completed on (mo/day/year) 5-11-11 and this record is true to the best of my knowledge and belief. Kansas Water Well Contractor's License No. 134. This Water Well Record was completed on (mo/day/year) 5-25-11 under the business name of Rosencrantz- Bemis by (signature) [Signature]

INSTRUCTIONS: Use typewriter or ballpoint pen. Please press firmly and print clearly. Please fill in blanks, underline or circle the correct answers. Send top three copies to Kansas Department of Health and Environment, Bureau of Water, Geology Section, 1000 SW Jackson St., Ste. 420, Topeka, Kansas 66612-1367. Telephone: 785/296-5524. Send one to Water Well Owner and retain one for your records. Visit us at http://www.kdheks.gov/waterwell/index.html.

Check one: [x] White Copy [] Blue Copy [] Pink Copy