USE TYPEWRITER OR BALL POINT PEN-PRESS FIRMLY, PRINT CLEARLY.

WATER WELL RECORD
KSA 82a-1201-1215

Kansas Department of Health and Environment-Division of Environment
(Water well Contractors)
Topeka, Kansas 66620

1. Location of well:	County	Fraction	Section number	Township number	Range number
	NESS	SW 1/4 SW 1/4 SW 1/4	22	T 20 S	R 23 E/W

2. Distance and direction from nearest town or city: 11 mi. south 3 east from Ness City Ks.
Street address of well location if in city:

3. Owner of well: REINERT BROTHERS
R.R. or street: RFD 1
City, state, zip code: NESS CITY, KANSAS 67560

4. Locate with "X" in section below:

Sketch map:

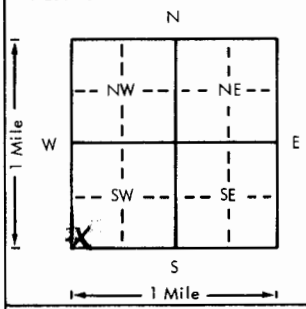

6. Bore hole dia. 8 in. Completion date 9/27/80
Well depth 83 ft.

7. __ Cable tool X Rotary __ Driven __ Dug
__ Hollow rod __ Jetted __ Bored __ Reverse rotary

8. Use: X Domestic __ Public supply __ Industry
__ Irrigation __ Air conditioning __ Stock
__ Lawn __ Oil field water __ Other

9. Casing: Materiol _____ Height: Above or below
Threaded ____ Welded ____ Surface 24 in.
RMP ____ PVC X Weight ____ lbs./ft.
Dia. 5 in. to 63 ft. depth Wall Thickness: inches or
Dia. ____ in. to ____ ft. depth gage No. SCH 40

5. Type and color of materiol	From	To
brown clay	0	42
fine sand	42	65
tan clay	65	67
sand (good)	67	78
black shale	78	83

(Use a second sheet if needed)

10. Screen: Manufacturer's name jet stream
Type PVC Dia. 5"
Slot/gauze .040" Length 20'
Set between 63 ft. and 83 ft.
____ ft. and ____ ft.
Gravel pack? yes Size range of materiol #1

11. Static water level: mo./day/yr.
70' ft. below land surface Date 9/27/80

12. Pumping level below land surfaces:
72' ft. after 4 hrs. pumping 12 g.p.m.
____ ft. after ____ hrs. pumping ____ g.p.m.
Estimated maximum yield 40-50 g.p.m.

13. Water sample submitted: mo./day/yr.
__ Yes X No Date ____

14. Well head completion:
X Pitless adapter 24 Inches above grade

15. Well grouted? yes
With: X Neat cement ____ Bentonite ____ Concrete
Depth: From 4 ft. to 15 ft.

16. Nearest source of possible contamination:
ft. 81 Direction west Type corral
Well disinfected upon completion? X Yes ____ No

17. Pump: ____ Not installed
Manufacturer's name REDA
Model number 9D9P051 HP 1/2 Volts 230
Length of drop pipe 80 ft. capacity 9 g.p.m.
Type:
X Submersible ____ Turbine
____ Jet ____ Reciprocating
____ Centrifugal ____ Other

18. Elevation:

Topography:
____ Hill
____ Slope
X Upland
____ Valley

19. Remarks:

20. Water well contractor's certification:
This well was drilled under my jurisdiction and this report is true to the best of my knowledge and belief.
DEAN WATERHOUSE DRILLING 243
Business name License No.
Address HANSTON, KANSAS 67849
Signed Dean Waterhouse Date 10/7/80
Authorized representative

T 20 R 23 (W) Sec 22 1/4 SW 1/4 SW 1/4

Forward the white, blue and pink copies to the Department of Health and Environment

Form WWC-5

MI-1023