


WATER WELL RECORD Form WWC-5 KSA 82A-1212

1 LOCATION OF WATER WELL: COUNTY: 068 NESS FRACTION: NW 1/4 NW 1/4 NW 1/4 SECTION NUMBER: 23 TOWNSHIP NUMBER: T 20 S RANGE NUMBER: R 25 W

DISTANCE AND DIRECTION FROM NEAREST TOWN OR CITY STREET ADDRESS OF WELL IF LOCATED WITHIN CITY?  
FROM NESS CITY; 9 3/4 MILES SOUTH & 8 1/4 MILES WEST

2 WATER WELL OWNER: THELMA FEHRENBACH RR#, St. Address, Box #: HC 61 BOARD OF AGRICULTURE, DIVISION OF WATER RESOURCES CITY, STATE, ZIP CODE: NESS CITY, KS 67560- APPLICATION NUMBER:

3 LOCATE WELL'S LOCATION WITH AN "X" IN SECTION BOX:

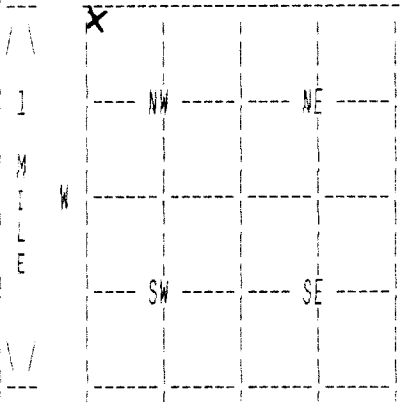

4 DEPTH OF COMPLETED WELL 380 ELEVATION: 0  
DEPTH(S) GROUNDWATER ENCOUNTERED 1. 0 FT. 2. 0 FT. 3. 0 FT.

WELL'S STATIC WATER LEVEL FT. BELOW LAND SURFACE MEASURED ON MO/DAY/YR  
PUMP TEST DATA: WELL WATER WAS 0 FT. AFTER 0 HOURS PUMPING 0 GPM

ESTIMATED YIELD 0 GPM; WELL WATER WAS 0 FT. AFTER 0 HOURS PUMPING 0 GPM

BORE HOLE DIAMETER 10 IN. TO 380 FT., AND IN. TO 0 FT.

WELL WATER TO BE USED AS: 01 DOMESTIC

WAS A CHEMICAL/BACTERIOLOGICAL SAMPLE SUBMITTED TO DEPARTMENT? No ;  
IF YES, MO/DAY/YR SAMPLE WAS SUBMITTED WATER WELL DISINFECTED? Yes

5 TYPE OF BLANK CASING USED: 02 PVC CASING JOINTS: GLUED  
BLANK CASING DIAMETER 5 IN. TO 380 FT., DIA IN. TO 0 FT., DIA IN. TO 0 FT.  
CASING HEIGHT ABOVE LAND SURFACE 12 IN., WEIGHT 3 LBS./FT. WALL THICKNESS OR GAUGE NO. .265  
TYPE OF SCREEN OR PERFORATION MATERIAL: 07 PVC  
SCREEN OR PERFORATION OPENINGS ARE: 03 MILL SLOT

SCREEN PERFORATED INTERVALS: FROM 300 FT. TO 380 FT., FROM 0 FT. TO 0 FT.  
GRAVEL PACK INTERVALS: FROM 0 FT. TO 0 FT., FROM 0 FT. TO 0 FT.  
FROM 25 FT. TO 380 FT., FROM 0 FT. TO 0 FT.  
FROM 0 FT. TO 0 FT., FROM 0 FT. TO 0 FT.

6 GROUT MATERIAL 03 BENTONITE  
GROUT INTERVALS: FROM 5 FT. TO 25 FT., FROM 0 FT. TO 0 FT., FROM 0 FT. TO 0 FT.  
WHAT IS THE NEAREST SOURCE OF POSSIBLE CONTAMINATION: #4 ABANDONED WELL  
DIRECTION FROM WELL? SOUTHWEST HOW MANY FEET? 28

FROM	TO	LITHOLOGIC LOG	FROM	TO	PLUGGING INTERVALS
0	1	02 SILT			
1	54	01 CLAY 05 SAND			
54	210	19 SHALE 31 CALICHE			
210	229	19 SHALE 31 CALICHE			
229	263	19 SHALE			
263	292	19 SHALE 23 SANDSTONE			
292	310	19 SHALE 23 SANDSTONE			
310	330	23 SANDSTONE 19 SHALE			
330	345	19 SHALE 23 SANDSTONE 01 CLAY			
345	374	23 SANDSTONE			

7 CONTRACTOR'S OR LANDOWNER'S CERTIFICATION: THIS WATER WELL WAS CONSTRUCTED UNDER MY JURISDICTION AND WAS COMPLETED ON (MO/DAY/YEAR) 07/13/01 AND THIS RECORD IS TRUE TO THE BEST OF MY KNOWLEDGE AND BELIEF. KANSAS WATER WELL CONTRACTOR'S LICENSE NO. 145 THIS WATER WELL RECORD WAS COMPLETED ON (MO/DAY/YR) 09/05/01 UNDER THE BUSINESS NAME OF HENKLE DRILLING & SUPPLY BY (SIGNATURE)

(CONTINUED)

WATER WELL RECORD Form WWC-5 KSA 82A-1212

1 LOCATION OF WATER WELL: COUNTY: 068 NESS	FRACTION NW 1/4 NW 1/4 NW 1/4	SECTION NUMBER 23	TOWNSHIP NUMBER T 20 S	RANGE NUMBER R 25 W
---	----------------------------------	----------------------	---------------------------	------------------------

2 WATER WELL OWNER: THELMA FEHRENBACH  
 RR#, ST. ADDRESS, BOX #: HC 61

BOARD OF AGRICULTURE, DIVISION OF WATER RESOURCES

CITY, STATE, ZIP CODE : NESS CITY, KS 67560-

APPLICATION NUMBER:

FROM	TO	LITHOLOGIC LOG
374	420	19 SHALE

7 CONTRACTOR'S OR LANDOWNER'S CERTIFICATION: THIS WATER WELL WAS CONSTRUCTED UNDER MY JURISDICTION AND WAS COMPLETED ON (MO/DAY/YEAR) 07/13/01 AND THIS RECORD IS TRUE TO THE BEST OF MY KNOWLEDGE AND BELIEF. KANSAS

WATER WELL CONTRACTOR'S LICENSE No. 145

THIS WATER WELL RECORD WAS COMPLETED ON (MO/DAY/YR) 09/05/01

UNDER THE BUSINESS NAME OF HENKLE DRILLING & SUPPLY

BY (SIGNATURE)

*Bruce Richmond*