


1 LOCATION OF WATER WELL: Fraction SW 1/4 SW 1/4 NE 1/4 Section Number 24 Township Number T 20 S Range Number R 25 E/W  
 County: Ness

Distance and direction from nearest town or city street address of well if located within city?  
 10 1/2 South 1 1/2 East of Laird, Kansas

2 WATER WELL OWNER: Layne Copeland  
 RR#, St. Address, Box #: Star Route  
 City, State, ZIP Code: Ness City, Kansas  
 Board of Agriculture, Division of Water Resources  
 Application Number:

3 LOCATE WELL'S LOCATION WITH AN "X" IN SECTION BOX:

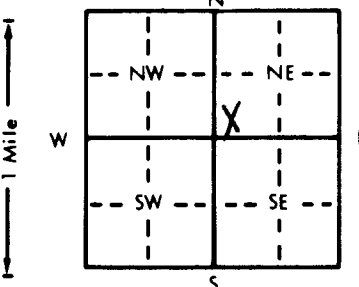

4 DEPTH OF COMPLETED WELL... 410' ft. ELEVATION: ...  
 Depth(s) Groundwater Encountered 1... 55 ft. 2... ft. 3... ft.  
 WELL'S STATIC WATER LEVEL .55 ft. below land surface measured on mo/day/yr .8-9-85  
 Pump test data: Well water was ... ft. after ... hours pumping ... gpm  
 Est. Yield . NA gpm: Well water was ... ft. after ... hours pumping ... gpm  
 Bore Hole Diameter... in. to ... ft., and... in. to ... ft.  
 WELL WATER TO BE USED AS: 5 Public water supply 8 Air conditioning 11 Injection well  
 1 Domestic 3 Feedlot 6 Oil field water supply 9 Dewatering 12 Other (Specify below)  
 2 Irrigation 4 Industrial 7 Lawn and garden only 10 Observation well  
 Was a chemical/bacteriological sample submitted to Department? Yes... No... X... If yes, mo/day/yr sample was submitted  
 Water Well Disinfected? Yes HTH No

5 TYPE OF BLANK CASING USED: 5 Wrought iron 8 Concrete tile CASING JOINTS: Glued X Clamped  
 1 Steel 3 RMP (SR) 6 Asbestos-Cement 9 Other (specify below) Welded  
 2 PVC 4 ABS 7 Fiberglass Threaded  
 Blank casing diameter .5 in. to .320 ft., Dia .5 in. to .340 - .390 ft., Dia ... in. to ... ft.  
 Casing height above land surface... in., weight ... lbs./ft. Wall thickness or gauge No. .258

TYPE OF SCREEN OR PERFORATION MATERIAL: 7 PVC 10 Asbestos-cement  
 1 Steel 3 Stainless steel 5 Fiberglass 8 RMP (SR) 11 Other (specify)  
 2 Brass 4 Galvanized steel 6 Concrete tile 9 ABS 12 None used (open hole)

SCREEN OR PERFORATION OPENINGS ARE: 5 Gauzed wrapped 8 Saw cut 11 None (open hole)  
 1 Continuous slot 3 Mill slot 6 Wire wrapped 9 Drilled holes  
 2 Louvered shutter 4 Key punched 7 Torch cut 10 Other (specify)

SCREEN-PERFORATED INTERVALS: From .320 ft. to .340 ft., From ... ft. to ... ft.  
 From .390 ft. to .410 ft., From ... ft. to ... ft.  
 GRAVEL PACK INTERVALS: From ... ft. to ... ft., From ... ft. to ... ft.

6 GROUT MATERIAL: 1 Neat cement 2 Cement grout 3 Bentonite 4 Other  
 Grout Intervals: From .0 ft. to .10 ft., From ... ft. to ... ft., From ... ft. to ... ft.

What is the nearest source of possible contamination:  
 1 Septic tank 4 Lateral lines 7 Pit privy 10 Livestock pens 14 Abandoned water well  
 2 Sewer lines 5 Cess pool 8 Sewage lagoon 11 Fuel storage 15 Oil well/Gas well  
 3 Watertight sewer lines 6 Seepage pit 9 Feedyard 12 Fertilizer storage 16 Other (specify below)  
 13 Insecticide storage  
 Direction from well? South How many feet? 120

FROM	TO	LITHOLOGIC LOG	FROM	TO	LITHOLOGIC LOG
0	3	Top Soil			
3	30	Clay			
30	190	Shale			
190	200	Stri Sand Shale			
200	250	Soft Shale			
250	260	White Clay			
260	330	Fire Clay			
330	340	Sand Rock			
340	410	Shale - Sand Rock			

7 CONTRACTOR'S OR LANDOWNER'S CERTIFICATION: This water well was (1) constructed, (2) reconstructed, or (3) plugged under my jurisdiction and was completed on (mo/day/year) .8-9-85 and this record is true to the best of my knowledge and belief. Kansas Water Well Contractor's License No. .134 This Water Well Record was completed on (mo/day/yr) .10-23-85 under the business name of Rosencrantz-Bemis Enterprises by (signature) Fredia Rodson

INSTRUCTIONS: Use typewriter or ball point pen, PLEASE PRESS FIRMLY and PRINT clearly. Please fill in blanks, underline or circle the correct answers. Send top three copies to Kansas Department of Health and Environment, Division of Environment, Environmental Geology Section, Topeka, KS 66620. Send one to WATER WELL OWNER and retain one for your records.

OFFICE USE ONLY  
T  
R  
E/W  
SEC.