

CORRECTION(S) TO WATER WELL RECORD (WWC-5)
(to rectify lacking or incorrect information)

County: Ness

Location listed as:

Location changed to:

Section-Township-Range: _____

18-20-26W

Fraction (1/4 1/4 1/4): _____

NE NE NE

Other changes: Initial statements: _____

County was listed as Hodgeman

Changed to: Ness Co.

Comments: _____

verification method: location of well, state & county maps

initials: DL

date: 8/3/2009


submitted by: Kansas Geological Survey, Data Resources Library, 1930 Constant Ave., Lawrence, KS 66047-3726
to: Kansas Dept of Health & Environment, Bureau of Water, 1000 SW Jackson, Suite 420, Topeka, KS 66612-1367.

WATER WELL RECORD Form WWC-5 KSA 82a-1212

1 LOCATION OF WATER WELL: Fraction: NE 1/4 NE 1/4 NE 1/4 Section Number: 18 Township Number: T 20 S Range Number: R 26 W
 COUNTY: HODGEMAN

Distance and direction from nearest town or city street address of well if located within city?
FROM KALVESTA CHURCH - 19 NORTH, 4 EAST AND 1 SOUTH

2 WATER WELL OWNER: STOUT, LEE
 RR#, St. Address, Box #: HCR 1 -- BOX 210 Board of Agriculture, Division of Water Resources
 City, State, ZIP code: BERLER, KS 67518- Application Number:

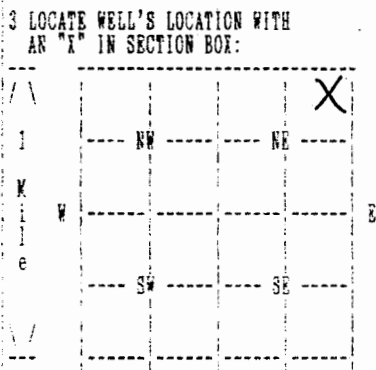

4 DEPTH OF COMPLETED WELL 57 ELEVATION: 0
 Depth(s) Groundwater Encountered: 1. 0 ft. 2. 0 ft. 3. 0 ft.
WELL'S STATIC WATER LEVEL 25 ft. below land surface measured on no/day/yr 05/31/96
 Pump test data: Well water was 0 ft. after 0 hours pumping 0 gpm
 Estimated Yield 40 gpm: Well water was 0 ft. after 0 hours pumping 0 gpm
Bore Hole Diameter 10 in. to 57 ft., and in. to 0 ft.
WELL WATER TO BE USED AS: DOMESTIC
 Was a chemical/bacteriological sample submitted to department? No;
 If yes, no/day/yr sample was submitted Water well disinfected? Yes

5 TYPE OF BLANK CASING USED: PVC CASING JOINTS: GLOED
 Blank casing diameter 5 in. to 57 ft., Dia in. to 0 ft., Dia in. to 0 ft.
 Casing height above land surface 12 in., weight 200 lbs/ft. Wall thickness or gauge No. 21
TYPE OF SCREEN OR PERFORATION MATERIAL: PVC
SCREEN OR PERFORATION OPENINGS ARE: SAW CUT

SCREEN PERFORATED INTERVALS: From 33 ft. to 53 ft., From 0 ft. to 0 ft.
 From 0 ft. to 0 ft., From 0 ft. to 0 ft.
GRAVEL PACK INTERVALS: From 25 ft. to 57 ft., From 0 ft. to 0 ft.
 From 0 ft. to 0 ft., From 0 ft. to 0 ft.

6 GROUT MATERIAL BENTONITE
 Grout intervals: From 0 ft. to 25 ft., From 0 ft. to 0 ft., From 0 ft. to 0 ft.
 What is the nearest source of possible contamination: **ABANDONED WELL**
 Direction from well? **EAST** How many feet? **6**

FROM	TO	LITHOLOGIC LOG	FROM	TO	PLUGGING INTERVALS
0	21	TOPSOIL CLAY			
21	53	COARSE SAND LARGE ROCK			
53	60	CLAY BLUE SHALE			

7 CONTRACTOR'S OR LANDOWNER'S CERTIFICATION: This water well was constructed under my jurisdiction and was completed on (no/day/year) 06/01/96 and this record is true to the best of my knowledge and belief. Kansas Water Well Contractor's license No. 179 This Water Well Record was completed on (no/day/yr) 06/07/96 under the business name of **JOE'S WELL SERVICE, INC.** by (signature) *Judith A. Cret*