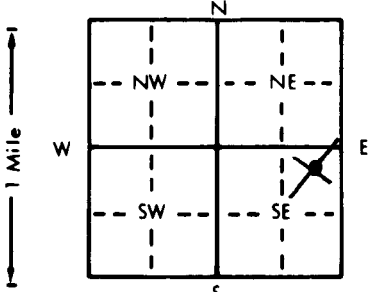


1 LOCATION OF WATER WELL:		Fraction	Section Number	Township Number	Range Number
County: McPherson		NE 1/4 NE 1/4 SE 1/4	22	T 20 S	R 3
Distance and direction from nearest town or city street address of well if located within city? 1/2 Mile North of Elyria					
2 WATER WELL OWNER: Sherwin Niehage					
RR#, St. Address, Box # : R.R. 1, Box 127N					
City, State, ZIP Code : McPherson, KS 67460					
Board of Agriculture, Division of Water Resources Application Number: 40,547					
3 LOCATE WELL'S LOCATION WITH AN "X" IN SECTION BOX:		4 DEPTH OF COMPLETED WELL: 7.6 ft. ELEVATION:			
		Depth(s) Groundwater Encountered 1. 4.0 ft. 2. 4.0 ft. 3. 4.0 ft.			
		WELL'S STATIC WATER LEVEL 4.0 ft. below land surface measured on mo/day/yr 6-13-95			
		Pump test data: Well water was 2.60 gpm: Well water was 25 ft. after 1 hours pumping 250 gpm			
		Bore Hole Diameter 3.0 in. to 7.6 ft. and 7.6 in. to 7.6 ft.			
		WELL WATER TO BE USED AS: 5 Public water supply 8 Air conditioning 11 Injection well 1 Domestic 3 Feedlot 6 Oil field water supply 9 Dewatering 12 Other (Specify below) 2 Irrigation 4 Industrial 7 Lawn and garden only 10 Monitoring well			
Was a chemical/bacteriological sample submitted to Department? Yes ☐ No ☒ If yes, mo/day/yr sample was submitted					
Water Well Disinfected? Yes ☒ No ☐					
5 TYPE OF BLANK CASING USED:					
1 Steel 3 RMP (SR) 5 Wrought iron 8 Concrete tile CASING JOINTS: Glued ☒ Clamped ☐					
2 PVC 4 ABS 6 Asbestos-Cement 9 Other (specify below) Welded ☐					
7 Fiberglass Threaded ☐					
Blank casing diameter 1.6 in. to 3.6 ft. Dia. 1.6 in. to 3.6 ft. Dia. 1.6 in. to 3.6 ft.					
Casing height above land surface 1.2 in. weight 1.6 lbs./ft. Wall thickness or gauge No. 500					
TYPE OF SCREEN OR PERFORATION MATERIAL:					
1 Steel 3 Stainless steel 5 Fiberglass 8 RMP (SR) 10 Asbestos-cement					
2 Brass 4 Galvanized steel 6 Concrete tile 9 ABS 11 Other (specify) ☐					
12 None used (open hole)					
SCREEN OR PERFORATION OPENINGS ARE:					
1 Continuous slot 3 Mill slot 5 Gauzed wrapped 8 Saw cut 11 None (open hole)					
2 Louvered shutter 4 Key punched 6 Wire wrapped 9 Drilled holes					
7 Torch cut 10 Other (specify) ☐					
SCREEN-PERFORATED INTERVALS: From 3.6 ft. to 7.6 ft. From 3.6 ft. to 7.6 ft. From 3.6 ft. to 7.6 ft.					
GRAVEL PACK INTERVALS: From 2.0 ft. to 7.6 ft. From 2.0 ft. to 7.6 ft. From 2.0 ft. to 7.6 ft.					
6 GROUT MATERIAL: 1 Neat cement 2 Cement grout 3 Bentonite 4 Other ☐					
Grout Intervals: From 0 ft. to 2.0 ft. From 0 ft. to 2.0 ft. From 0 ft. to 2.0 ft.					
What is the nearest source of possible contamination:					
1 Septic tank 4 Lateral lines 7 Pit privy 10 Livestock pens 14 Abandoned water well					
2 Sewer lines 5 Cess pool 8 Sewage lagoon 11 Fuel storage 15 Oil well/Gas well					
3 Watertight sewer lines 6 Seepage pit 9 Feedyard 12 Fertilizer storage 16 Other (specify below) ☐					
13 Insecticide storage					
Direction from well? Southwest How many feet? 600 ft					
FROM		TO		LITHOLOGIC LOG	
FROM		TO		PLUGGING INTERVALS	
0		3		Top Soil	
3		35		Clay Brown Hard	
35		36		Sand-Med.	
36		40		Clay-Brown	
40		44		Sand-Fine Hard	
44		46		Sandstone	
46		65		Sand-Very Fine Hard	
65		74		Sand-Medium-Water Loss	
74		76		Shale-Green	
7 CONTRACTOR'S OR LANDOWNER'S CERTIFICATION: This water well was (1) constructed, (2) reconstructed, or (3) plugged under my jurisdiction and was completed on (mo/day/year) 6-13-95 and this record is true to the best of my knowledge and belief. Kansas Water Well Contractor's License No. 138 This Water Well Record was completed on (mo/day/yr) 6-22-95 under the business name of Peterson Irrigation Inc. by (signature)					