

1 LOCATION OF WATER WELL:		Fraction	Section Number	Township Number	Range Number
County: <b>McPherson</b>		<b>SW ¼ NW ¼ SW ¼</b>	<b>3</b>	<b>T 20 S</b>	<b>R 3 E</b> <b>(W)</b>

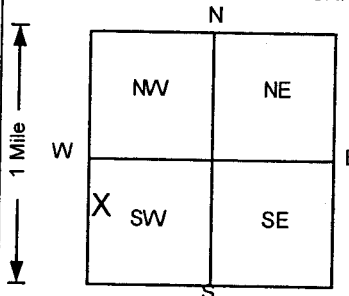
Distance and direction from nearest town or city street address of well if located within city?

**NCRA Refinery, Hwy 81 & Ironhorse Rd, McPherson**

## 2 WATER WELL OWNER: NCRA

RR#, St. Address, Box # : **1391 Ironhorse Road**City, State, ZIP Code : **McPherson, Kansas 67460**Board of Agriculture, Division of Water Resources  
Application Number:

## 3 LOCATE WELL'S LOCATION WITH AN "X" IN SECTION BOX:

4 DEPTH OF COMPLETED WELL: **145.5** ft. ELEVATION: **1485.02**

Depth(s) Groundwater Encountered 1. .... ft. 2. .... ft. 3. .... ft.

WELL'S STATIC WATER LEVEL **71.7** ft. below land surface measured on mo/day/yr **3/20/03**Pump test data: Well water was **NA** ft. after .... hours pumping .... gpmEst. Yield **NA** gpm: Well water was .... ft. after .... hours pumping .... gpmBore Hole Diameter **9** in. to **20** ft. and **6.5** in. to **154** ft.

WELL WATER TO BE USED AS: 5 Public water supply 8 Air conditioning 11 Injection well

1 Domestic 3 Feedlot 6 Oil field water supply 9 Dewatering 12 Other (Specify below)

2 Irrigation 4 Industrial 7 Lawn and garden only **10 Monitoring well**Was a chemical/bacteriological sample submitted to Department? Yes.....No ☒ If yes, mo/day/yr sample was submittedWater Well Disinfected? Yes No ☒

## 5 TYPE OF BLANK CASING USED:

1 Steel 3 RMP (SR) 5 Wrought iron 8 Concrete tile CASING JOINTS: Glued ..... Clamped .....

**2 PVC** 4 ABS 6 Asbestos-Cement 9 Other (specify below) Welded .....Blank casing diameter **2** in. to **125.5** ft. Dia. .... in. to .... ft. Dia. .... in. to .... ft.Casing height above land surface **28.32** in. weight .... lbs./ft. Wall thickness or gauge No. **Sch. 40**

## TYPE OF SCREEN OR PERFORATION MATERIAL

1 Steel 3 Stainless steel 5 Fiberglass **7 PVC** 10 Asbestos-cement

2 Brass 4 Galvanized steel 6 Concrete tile 8 RMP (SR) 11 Other (specify) .....

SCREEN OR PERFORATION OPENINGS ARE: 5 Gauzed wrapped 8 Saw cut 11 None (open hole)

1 Continuous slot **3 Mill slot** 6 Wire wrapped 9 Drilled holes

2 Louvered shutter 4 Key punched 7 Torch cut 10 Other (specify) .....

SCREEN-PERFORATED INTERVALS: From **125.5** ft. to **145.5** ft. From .... ft. to .... ft.GRAVEL PACK INTERVALS: From **119.5** ft. to **154** ft. From .... ft. to .... ft.

From .... ft. to .... ft. From .... ft. to .... ft.

From .... ft. to .... ft. From .... ft. to .... ft.

