

## WATER WELL PLUGGING RECORD

Form WWC-5P

KSA 82a-1212

ID No.

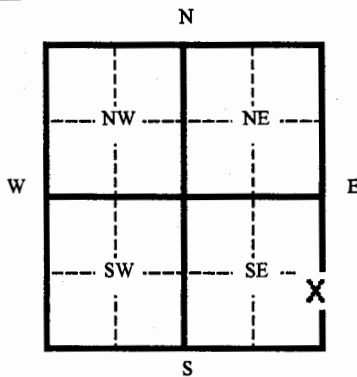
1 LOCATION OF WATER WELL:	Fraction	Section Number	Township Number	Range Number
County: <b>McPherson</b>	<b>NE ¼ SE ¼ SE ¼</b>	<b>5</b>	<b>20</b>	<b>03 W</b>

Distance and direction from nearest town or city street address of well if located within city?

**1229 ft. N & 429 ft W of the SE corner of the Section**

2 WATER WELL OWNER:	<b>KDHE</b>	Board of Agriculture, Division of Water Resources
RR#, St. Address, Box #	<b>1000 SW Jackson, Ste 410</b>	Application Number:
City, State, ZIP Code :	<b>Topeka, KS 66612</b>	

3 MARK WELL'S LOCATION WITH AN "X" IN SECTION BOX:

4 DEPTH OF WELL **92.5** ft.WELL'S STATIC WATER LEVEL **~80** ft.

WELL WAS USED AS:

- |              |                              |                           |
|--------------|------------------------------|---------------------------|
| 1 Domestic   | 5 Public Water Supply        | 9 Dewatering              |
| 2 Irrigation | 6 Oil Field Water Supply     | <b>10 Monitoring Well</b> |
| 3 Feedlot    | 7 Lawn and Garden (domestic) | 11 Injection Well         |
| 4 Industrial | 8 Air Conditioning           | 12 Other                  |

Was a chemical/bacteriological sample submitted to Department? Yes \_\_\_ No **X**

If yes, mo/day/yr sample was submitted

Water Well Disinfected: Yes \_\_\_ No **X**

5 TYPE OF BLANK CASING USED:

- |              |            |                   |                 |                         |
|--------------|------------|-------------------|-----------------|-------------------------|
| 1 Steel      | 3 RMP (SR) | 5 Wrought         | 7 Fiberglass    | 9 Other (specify below) |
| <b>2 PVC</b> | 4 ABC      | 6 Asbestos-Cement | 8 Concrete Tile |                         |

Blank casing diameter **2** in. Was casing pulled? Yes \_\_\_ No **X** If yes, how muchCasing height above or below land surface **36** in. **Overdrilled from 0 to 3 ft. below the ground surface.**6 GROUT PLUG MATERIAL: 1 Neat cement 2 Cement grout 3 Bentonite **4 Other Bentonite Grout**Grout Plug Intervals From **3** ft. to **92.5** ft. From \_\_\_ ft. to \_\_\_ ft. From \_\_\_ ft. to \_\_\_ ft.

What is the nearest source of possible contamination:

- |                          |                   |                         |                          |
|--------------------------|-------------------|-------------------------|--------------------------|
| 1 Septic tank            | 6 Seepage pit     | 11 Fuel storage         | 16 Other (specify below) |
| 2 Sewer lines            | 7 Pit privy       | 12 Fertilizer storage   |                          |
| 3 Watertight sewer lines | 8 Sewage lagoon   | 13 Insecticide storage  |                          |
| 4 Lateral lines          | 9 Feedyard        | 14 Abandoned water well |                          |
| 5 Cess Pool              | 10 Livestock pens | 15 Oil well/ Gas well   |                          |

Direction from well? \_\_\_\_\_

How many feet? \_\_\_\_\_

FROM	TO	CODE	PLUGGING MATERIALS
<b>0</b>	<b>3</b>		<b>Soil</b>
<b>3</b>	<b>92.5</b>		<b>Bentonite Grout, tremied/72 gal.</b>

**Note: Casing blocked @ 33'.****Used A-rods to clear casing to TD.****Tremied grout through A-rods.**

7	CONTRACTOR'S OR LANDOWNER'S CERTIFICATION: This water well was plugged under my jurisdiction and was completed on (mo/day/yr) <b>5-10-05</b> and this record is true to the best of my knowledge and belief. Kansas Water Well Contractor's License No. <b>531</b> This Water Well Record was completed on (mo/day/yr) <b>5-25-05</b> under the business name of <b>Geotechnical Services, Inc.</b> by (signature) <i>[Signature]</i>
---	---

INSTRUCTIONS: Please fill in blanks and circle the correct answers. Send three copies to Kansas Department of Health and Environment, Bureau of Water, 1000 S W Jackson St., Ste. 420, Topeka, Kansas 66620-0001. Telephone: 785-296-3565. Send one to Water Well Owner and retain one for your records.