

CORRECTION(S) TO WATER WELL RECORD (WWC-5)

(to rectify lacking or incorrect information)

Location listed as:

County: McPherson

Location changed to:

Section-Township-Range: None Given

5-205-3 W

Fraction ($\frac{1}{4}$ $\frac{1}{4}$ $\frac{1}{4}$): _____

NE SE SE

Other changes: Initial statements: _____

Changed to: _____

Comments: _____

verification method: Latitude and longitude, conversion tool on KGS website, and mapping tool on KGS website.


initials: DRf date: 6/6/2006

submitted by: Kansas Geological Survey, Data Resources Library, 1930 Constant Ave., Lawrence, KS 66047-3726
to: Kansas Dept of Health & Environment, Bureau of Water, 1000 SW Jackson, Suite 420, Topeka, KS 66612-1367.

WATER WELL RECORD SVE 01 IS Form WWC-5

Division of Water Resources; App. No.

1 LOCATION OF WATER WELL: County: <u>McPherson</u>		Fraction 1/4 1/4 1/4		Section Number		Township Number T S		Range Number R E/W					
Distance and direction from nearest town or city street address of well if located within city? <u>North of Frontier Road on 14th Avenue, McPherson, KS</u>		Global Positioning Systems (decimal degrees, min. of 4 digits) Latitude: <u>38° 20.211 = 38.3368° N</u> Longitude: <u>97° 40.082 = 97.6680° W</u> Elevation: _____ Datum: _____ Data Collection Method: _____											
2 WATER WELL OWNER: <u>El Paso Merchant Energy Company</u> RR#, St. Address, Box # <u>El Paso Corporation</u> City, State, ZIP Code <u>Environmental Remediation Department</u> <u>2 North Nevada Avenue, Room 432</u> <u>Colorado Springs, CO 80903</u>													
3 LOCATE WELL'S LOCATION WITH AN "X" IN SECTION BOX: N <table border="1" style="margin: auto; border-collapse: collapse; text-align: center;"> <tr> <td style="width: 20px;">NW</td> <td style="width: 20px;">NE</td> </tr> <tr> <td style="width: 20px;">SW</td> <td style="width: 20px;">SE</td> </tr> </table> S W E		NW	NE	SW	SE	4 DEPTH OF COMPLETED WELL <u>40</u> ft. Depth(s) Groundwater Encountered (1) <u>Dry</u> ft. (2) _____ ft. (3) _____ ft. WELL'S STATIC WATER LEVEL _____ ft. below land surface measured on mo/day/yr. _____ Pump test data: Well water was _____ ft. after _____ hours pumping _____ gpm Est. Yield _____ gpm: Well water was _____ ft. after _____ hours pumping _____ gpm WELL WATER TO BE USED AS: 5 Public water supply 8 Air conditioning 11 Injection well 1 Domestic 3 Feedlot 6 Oil field water supply 9 Dewatering 12 Other (Specify below) 2 Irrigation 4 Industrial 7 Domestic (lawn & garden) ☒ Monitoring well _____ Was a chemical/bacteriological sample submitted to Department? Yes _____ No _____; If yes, mo/day/yr Sample was submitted _____ Water well disinfected? Yes _____ No _____							
NW	NE												
SW	SE												
5 TYPE OF CASING USED: 1 Steel 3 RMP (SR) 5 Wrought Iron 8 Concrete tile ☒ PVC 4 ABS 7 Fiberglass 9 Other (specify below) _____ Blank casing diameter _____ in. to <u>30</u> ft., Diameter _____ in. to _____ ft., Diameter _____ in. to _____ ft. Casing height above land surface _____ in., Weight _____ lbs./ft. Wall thickness or gauge No. <u>Sch 40</u>		CASING JOINTS: Glued _____ Clamped _____ Welded _____ Threaded ☒											
TYPE OF SCREEN OR PERFORATION MATERIAL: 1 Steel 3 Stainless Steel 5 Fiberglass ☒ PVC 9 ABS 11 Other (Specify) _____ 2 Brass 4 Galvanized Steel 6 Concrete tile 8 RM (SR) 10 Asbestos-Cement 12 None used (open hole)		SCREEN OR PERFORATION OPENINGS ARE: ☒ Continuous slot 3 Mill slot 5 Gauzed wrapped 7 Torch cut 9 Drilled holes 11 None (open hole) 2 Louvered shutter 4 Key punched 6 Wire wrapped 8 Saw Cut 10 Other (specify) _____ SCREEN-PERFORATED INTERVALS: From <u>30</u> ft. to <u>40</u> ft., From _____ ft. to _____ ft. From _____ ft. to _____ ft., From _____ ft. to _____ ft. GRAVEL PACK INTERVALS: From <u>28</u> ft. to <u>40</u> ft., From _____ ft. to _____ ft. From _____ ft. to _____ ft., From _____ ft. to _____ ft.											
6 GROUT MATERIAL: ☒ Neat cement 2 Cement grout ☒ Bentonite 4 Other _____ Grout Intervals: From _____ ft. to <u>26</u> ft., From <u>26</u> ft. to <u>28</u> ft., From _____ ft. to _____ ft. What is the nearest source of possible contamination: 1 Septic tank 4 Lateral lines 7 Pit privy 10 Livestock pens 13 Insecticide Storage 16 Other (specify below) 2 Sewer lines 5 Cess pool 8 Sewage lagoon 11 Fuel storage 14 Abandoned water well 3 Watertight sewer lines 6 Seepage pit 9 Feedyard 12 Fertilizer Storage 15 Oil well/gas well		Direction from well? _____ How many feet? _____											
7 CONTRACTOR'S OR LANDOWNER'S CERTIFICATION: This water well was ☒ constructed, (2) reconstructed, or (3) plugged under my jurisdiction and was completed on (mo/day/year) <u>03/29/06</u> ... and this record is true to the best of my knowledge and belief. Kansas Water Well Contractor's License No. <u>551</u> ... This Water Well Record was completed on (mo/day/year) <u>04/19/06</u> ... under the business name of <u>Associated Environmental Industries Corp</u> (signature) <u>Madeline James</u>													
INSTRUCTIONS: Use typewriter or ball point pen. <u>PLEASE PRESS FIRMLY</u> and <u>PRINT</u> clearly. Please fill in blanks, underline or circle the correct answers. Send top three copies to Kansas Department of Health and Environment, Bureau of Water, Geology Section, 1000 SW Jackson St., Suite 420, Topeka, Kansas 66612-1367. Telephone 785-296-5522. Send one to WATER WELL OWNER and retain one for your records. Fee of \$5.00 for each <u>constructed</u> well. Visit us at http://www.kdhe.state.ks.us/geo/waterwells .													

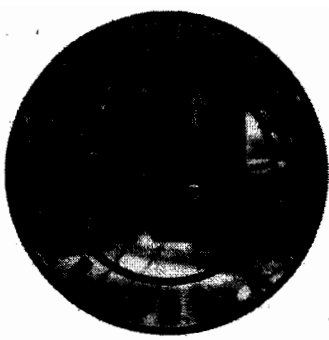

Associated Environmental Industries, Corp.

PO Box 5300 Norman, Oklahoma 73070
Phone: (405) 360-1434 FAX: (405) 360-1480

The purpose of the multi-level wells at McPherson was to monitor the vapors in the unsaturated zone at various depth intervals during a Soil Vapor Extraction Pilot Test to be conducted by our client, MWH Americas.