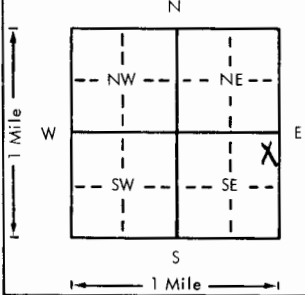


USE TYPEWRITER OR BALL  
POINT PEN-PRESS FIRMLY,  
PRINT CLEARLY.

WATER WELL RECORD  
KSA 82a-1201-1215

Kansas Department of Health and  
Environment-Division of Environment  
(Water well Contractors)  
Topeka, Kansas 66620

1. Location of well:		County <b>McPherson</b>	Fraction <b>ne<sub>1/4</sub> ne<sub>1/4</sub> se<sub>1/4</sub></b>	Section number <b>5</b>	Township number <b>20</b>	Range number <b>3</b>	<b>X<sub>E</sub>/W</b>
2. Distance and direction from nearest town or city: <b>1 1/8 miles south of McPherson, Ks.</b> Street address of well location if in city: <b>city limits, west side rd.</b>				3. Owner of well: <b>Derby Terminal</b> R.R. or street: <b>Box 1030</b> City, state, zip code: <b>Wichita, Ks. 67201</b>			
4. Locate with "X" in section below:		Sketch map:		6. Bore hole dia. <b>9 7/8</b> Completion date <b>6-25-79</b> Well depth <b>75</b> ft.			
				7. <input checked="" type="checkbox"/> Cable tool <input checked="" type="checkbox"/> Rotary <input type="checkbox"/> Driven <input type="checkbox"/> Dug <input type="checkbox"/> Hollow rod <input type="checkbox"/> Jetted <input type="checkbox"/> Bored <input type="checkbox"/> Reverse rotary			
5. Type and color of material		From		To		8. Use: <input type="checkbox"/> Domestic <input type="checkbox"/> Public supply <input type="checkbox"/> Industry <input type="checkbox"/> Irrigation <input type="checkbox"/> Air conditioning <input type="checkbox"/> Stock <input type="checkbox"/> Lawn <input type="checkbox"/> Oil field water <input checked="" type="checkbox"/> Other <b>observ</b>	
Top soil		0		3		9. Casing: Material <b>pvc</b> Weight: Above or below Threaded <input type="checkbox"/> Welded <input type="checkbox"/> Surface <b>36</b> in. RMP <b>4 1/2</b> PVC <input checked="" type="checkbox"/> Weight <b>75</b> lbs./ft. Dia. <b>4 1/2</b> in. to <b>75</b> ft. depth Wall Thickness: inches or Dia. <b>4 1/2</b> in. to <b>75</b> ft. depth gage No. <b>237</b>	
Hard clay		3		33		10. Screen: Manufacturer's name <b>certainteed</b> Type <b>pvc</b> Dia. <b>4 1/2</b> Slot/gauge <b>1/16</b> Length <b>20</b> Set between <b>55</b> ft. and <b>75</b> ft. ft. and <b>75</b> ft.	
Fine sand		33		36		Gravel pack? <input checked="" type="checkbox"/> Size range of material <b>3/4-5/8</b>	
Sandy clay		36		40		11. Static water level: <b>dry</b> ft. below land surface Date <b>6-25-79</b>	
Fine sand		40		47		12. Pumping level below land surfaces: <b>dry hole</b> ft. <b>dry hole</b> pumping <b>dry hole</b> g.p.m. ft. after <b>dry hole</b> hrs. pumping <b>dry hole</b> g.p.m. Estimated maximum yield <b>dry hole</b> g.p.m.	
Sand		47		50		13. Water sample submitted: <b>dry</b> mo./day/yr.	
Brown clay		50		64		14. Well head completion: <input type="checkbox"/> Pitless adapter <input type="checkbox"/> Inches above grade	
Sand		64		68		15. Well grouted? <input checked="" type="checkbox"/> <b>X</b> With: <input checked="" type="checkbox"/> Neat cement <input type="checkbox"/> Bentonite <input type="checkbox"/> Concrete Depth: From <b>0</b> ft. to <b>10</b> ft.	
Hard clay		68		75		16. Nearest source of possible contamination: ft. <b>600</b> Direction <b>se</b> Type <b>fuel tank</b> Well disinfected upon completion? <input type="checkbox"/> Yes <input type="checkbox"/> No	
						17. Pump: <input checked="" type="checkbox"/> Not installed Manufacturer's name <b>no</b> Model number <b>centrantz-Bemis 134</b> HP <b>1/4</b> Volts <b>NE</b> Length of drop pipe <b>30</b> ft. capacity <b>30</b> g.p.m. Type: <input type="checkbox"/> Submersible <input type="checkbox"/> Turbine <input type="checkbox"/> Reciprocating <input type="checkbox"/> Other	
						20. Water well contractor's certification: This well was drilled under my jurisdiction and this report is true to the best of my knowledge and belief. <b>no</b> Business name <b>centrantz-Bemis 134</b> License No. <b>134</b> Address <b>box 713 -Great Bend,</b> Signed <b>Freddie Rodson</b> Date <b>7/25/79</b> Authorized representative	
18. Elevation:		19. Remarks:					
Topography: <input type="checkbox"/> Hill <input checked="" type="checkbox"/> Slope <input type="checkbox"/> Upland <input type="checkbox"/> Valley							

Forward the white, blue and pink copies to the Department of Health and Environment

Form WWC-5