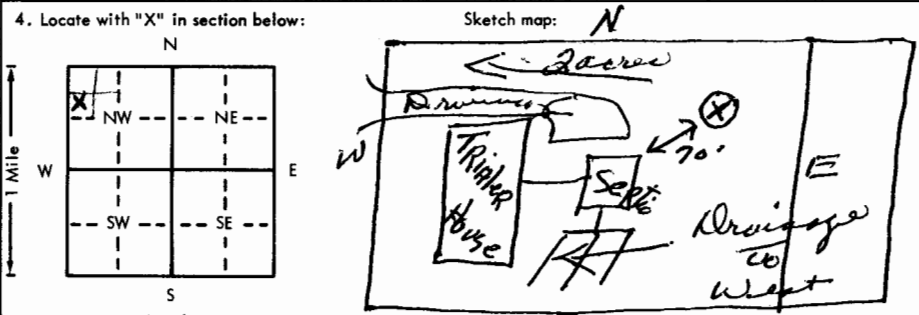


USE TYPEWRITER OR BALL POINT PEN-PRESS FIRMLY, PRINT CLEARLY.

WATER WELL RECORD
KSA 82a-1201-1215

Kansas Department of Health and Environment-Division of Environment
(Water well Contractors)
Topeka, Kansas 66620

1. Location of well:	County: <u>McPherson</u>	Fraction: <u>SW NW 1/4 SW 1/4 NW 1/4</u>	Section number: <u>15</u>	Township number: T <u>20</u> S	Range number: R <u>3</u> (E/W)
2. Distance and direction from nearest town or city: <u>1 1/2 SE of McPherson</u> Street address of well location if in city: <u>Along 81 Highway</u>			3. Owner of well: <u>Daryl Becker</u> R.R. or street: <u>R.R. 2, McPherson</u> City, state, zip code: <u>67460</u>		
4. Locate with "X" in section below: 			6. Bore hole dia. <u>8</u> in. Completion date <u>2-24-76</u> Well depth <u>120</u> ft.		
5. Type and color of material			7. <input checked="" type="checkbox"/> Cable tool <input checked="" type="checkbox"/> Rotary <input type="checkbox"/> Driven <input type="checkbox"/> Dug <input type="checkbox"/> Hollow rod <input type="checkbox"/> Jetted <input type="checkbox"/> Bored <input type="checkbox"/> Reverse rotary		
			8. Use: <input checked="" type="checkbox"/> Domestic <input type="checkbox"/> Public supply <input type="checkbox"/> Industry <input type="checkbox"/> Irrigation <input type="checkbox"/> Air conditioning <input type="checkbox"/> Stock <input type="checkbox"/> Lawn <input type="checkbox"/> Oil field water <input type="checkbox"/> Other		
			9. Casing: Material <u>PEST</u> Height: Above or below Threaded <input type="checkbox"/> Welded <input checked="" type="checkbox"/> Surface <u>1 1/2</u> in. RMP <input type="checkbox"/> PVC <input checked="" type="checkbox"/> Weight <input type="checkbox"/> lbs./ft. Dia. <u>5</u> in. to <u>120</u> ft. depth Wall Thickness: inches or Dia. <input type="checkbox"/> in. to <input type="checkbox"/> ft. depth Gauge No. <u>3/8</u>		
			10. Screen: Manufacturer's name <u>Jet Stream</u> <u>Ralph Jones Co.</u> Type <u>PVC</u> Dia. <u>5</u> " Slot/gauze <u>1/16</u> Length <u>20</u> ' Set between <u>120</u> ft. and <u>100</u> ft. ft. and <input type="checkbox"/> ft. Gravel pack? <input checked="" type="checkbox"/> Size range of material <u>1/8" - 1/4"</u>		
			11. Static water level: <u>55</u> ft. below land surface Date <u>2-24-76</u> mo./day/yr.		
			12. Pumping level below land surfaces: <u>65</u> ft. after <u>1</u> hrs. pumping <u>8</u> g.p.m. <u>55</u> ft. after <u>1/2</u> hrs. pumping <u>8</u> g.p.m. Estimated maximum yield <u>15-25</u> g.p.m.		
			13. Water sample submitted: <input type="checkbox"/> Yes <input checked="" type="checkbox"/> No Date _____ mo./day/yr.		
			14. Well head completion: <input checked="" type="checkbox"/> Pitless adapter <u>18</u> " inches above grade		
			15. Well grouted? <u>yes</u> With: <input checked="" type="checkbox"/> Neat cement <input type="checkbox"/> Bentonite <input type="checkbox"/> Concrete Depth: From <u>7</u> ft. to <u>14</u> ft.		
			16. Nearest source of possible contamination: ft. <u>70</u> Direction <u>SW</u> Type <u>Septic</u> Well disinfected upon completion? <input checked="" type="checkbox"/> Yes <input type="checkbox"/> No		
			17. Pump: <input checked="" type="checkbox"/> Not installed Manufacturer's name _____ Model number _____ HP _____ Volts _____ Length of drop pipe _____ ft. capacity _____ g.p.m. Type: <input type="checkbox"/> Submersible <input checked="" type="checkbox"/> Turbine <input type="checkbox"/> Jet <input type="checkbox"/> Reciprocating <input type="checkbox"/> Centrifugal <input checked="" type="checkbox"/> Other		
			(Use a second sheet if needed)		
18. Elevation: Topography: <input type="checkbox"/> Hill <input checked="" type="checkbox"/> Slope <input checked="" type="checkbox"/> Upland <input type="checkbox"/> Valley		19. Remarks: <u>Daryl knows he has to pour concrete slab 4' square around new well.</u>			
		20. Water well contractor's certification: This well was drilled under my jurisdiction and this report is true to the best of my knowledge and belief. <u>Retson Brune</u> 138 Business name _____ License No. _____ Address <u>Box 150 Lindaville, KS</u> Signed <u>Wally Pelison</u> Date <u>2-25</u> Authorized representative			

20 - 30 E 15 SW NW NW