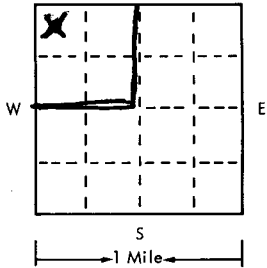
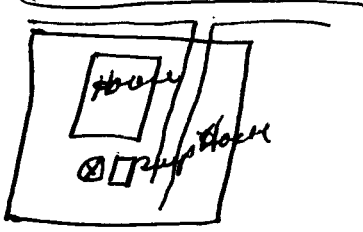


USE TYPEWRITER OR BALL
POINT PEN-PRESS FIRMLY,
PRINT CLEARLY.

WATER WELL RECORD
KSA 82a-1201-1215

T R EW sec 1/4 1/4 1/4 No.

Kansas State Dept. Of Health
(Water Well Contractors)
Forbes-Bldg. 740
Topeka, Kansas 66620

1 Location of well:	County <u>McPherson</u>	Township name <u>King City</u>	Fraction <u>NE 1/4 - SE 1/4</u>	Section number <u>17</u>	Town number <u>T-20-S</u>	Range number <u>R-3-W</u>																																			
Distance and direction from nearest town or city: <u>2 1/2 mi McPherson</u>			3 Owner of well: <u>Billy Patter</u>																																						
Street address of well location if in city:			Address: <u>RR. 1 - McPherson, Kans.</u>																																						
Locate with "X" in section below: 			Sketch map: 			4 Well depth: <u>73</u> ft. Date of completion <u>4-17-75</u> Well diameter <u>8"</u> in.																																			
<table border="1"><thead><tr><th>2</th><th>Type and color of material</th><th>From</th><th>To</th></tr></thead><tbody><tr><td></td><td><u>Top Soil</u></td><td><u>0</u></td><td><u>3</u></td></tr><tr><td></td><td><u>Dark clays</u></td><td><u>3</u></td><td><u>7</u></td></tr><tr><td></td><td><u>Red Buff Clays</u></td><td><u>7</u></td><td></td></tr><tr><td></td><td><u>& Lime rock</u></td><td></td><td><u>47</u></td></tr><tr><td></td><td><u>Gray clays</u></td><td><u>47</u></td><td><u>52</u></td></tr><tr><td></td><td><u>Fine sands & clays</u></td><td><u>52</u></td><td><u>55</u></td></tr><tr><td></td><td><u>Med coarse sand & gravel</u></td><td><u>55</u></td><td><u>75</u></td></tr><tr><td></td><td>(use a second sheet if needed)</td><td></td><td></td></tr>tool <input checked="" type="checkbox"/> Rotary <input type="checkbox"/> Driven <input type="checkbox"/> Dug <input type="checkbox"/> Hollow rod <input type="checkbox"/> Jetted <input type="checkbox"/> Bored <input type="checkbox"/> Reverse rotary		
			2	Type and color of material	From	To																																			
				<u>Top Soil</u>	<u>0</u>	<u>3</u>																																			
				<u>Dark clays</u>	<u>3</u>	<u>7</u>																																			
				<u>Red Buff Clays</u>	<u>7</u>																																				
	<u>& Lime rock</u>		<u>47</u>																																						
	<u>Gray clays</u>	<u>47</u>	<u>52</u>																																						
	<u>Fine sands & clays</u>	<u>52</u>	<u>55</u>																																						
	<u>Med coarse sand & gravel</u>	<u>55</u>	<u>75</u>																																						
	(use a second sheet if needed)	
6 Use: <input checked="" type="checkbox"/> Domestic <input type="checkbox"/> Public supply <input type="checkbox"/> Industry <input type="checkbox"/> Irrigation <input type="checkbox"/> Air conditioning <input type="checkbox"/> Commercial <input type="checkbox"/> Test well <input type="checkbox"/>	
7 Casing: Material <u>PVC</u> Height <u>above</u> below Threaded <input type="checkbox"/> Welded <input checked="" type="checkbox"/> Surface <u>12</u> in. Diam. <u>3</u> in. to <u>23</u> ft. depth Weight <u> </u> lbs./ft. <u> </u> <u> </u> in. to <u> </u> ft. depth Drive shoe? <input type="checkbox"/> Yes <input type="checkbox"/> No	
8 Screen: <u>British Steel</u> Manufacture <u>PVC</u> Dia. <u>5"</u> Type <u>Y32</u> Length <u>10 ft</u> Slot/gauze <u>63</u> ft. and <u>73</u> ft. <u> </u> Set between <u> </u> ft. and <u> </u> ft. <u> </u> Fittings: <u>406 - 1/4"</u> Gravel pack <input checked="" type="checkbox"/> Yes <input type="checkbox"/> No Size range of material <u> </u>	
9 Static water level: <u>57 1/2</u> ft. below land surface Date <u>4-17-75</u>	
10 Pumping level below land surfaces: <u>60</u> ft. after <u>2</u> hrs. pumping <u>15</u> g.p.m. <u> </u> ft. after <u> </u> hrs. pumping <u> </u> g.p.m. Estimated maximum yield <u>30</u> g.p.m.	
11 Water sample submitted: <input type="checkbox"/> Yes <input checked="" type="checkbox"/> No Date <u> </u>	
12 Well head completion: <input checked="" type="checkbox"/> Pitless adapter <u>12"</u> inches above grade	
13 Well grouted? <input checked="" type="checkbox"/> Yes <input type="checkbox"/> No <input checked="" type="checkbox"/> Neat cement <input type="checkbox"/> Bentonite <u> </u> Depth: From <u>4</u> ft. to <u>14</u> ft.	
14 Nearest source of possible contamination: ft. <u>100</u> Direction <u>N.E.</u> Type <u>Sept</u> Well disinfected upon completion? <input checked="" type="checkbox"/> Yes <input type="checkbox"/> No	
15 Pump: <input checked="" type="checkbox"/> Not installed Manufacturer's name <u> </u> Model number <u> </u> HP <u> </u> Volts <u> </u> Length of drop pipe <u> </u> ft. capacity <u> </u> g.m.p. Type: <input type="checkbox"/> Submersible <input type="checkbox"/> Turbine <input type="checkbox"/> Jet <input type="checkbox"/> Reciprocating <input type="checkbox"/> Centrifugal <input type="checkbox"/> Other	
16 Remarks: elevation Topography: <u>Farm yard and surrounding area all flat</u> <input type="checkbox"/> Hill <input type="checkbox"/> Slope <input checked="" type="checkbox"/> Upland <input type="checkbox"/> Valley	
17 Water well contractor's certification: This well was drilled under my jurisdiction and this report is true to the best of my knowledge and belief. <u>Peterson Bros INC</u> <u>138</u> Business name License No. Address <u>Box 150 Lindsay, Kans</u> Signed <u>Wallace Peterson</u> Date <u>4-18-75</u> <u>By T.P.</u> Authorized representative	

Forward the white, blue and pink copies to the Kansas State Dept. Of Health.

Form WWC-5