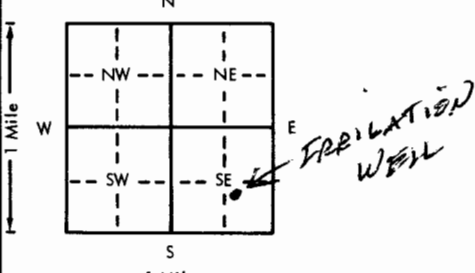


USE TYPEWRITER OR BALL
POINT PEN-PRESS FIRMLY,
PRINT CLEARLY.

WATER WELL RECORD
KSA 82a-1201-1215

Kansas Department of Health and
Environment-Division of Environment
(Water well Contractors)
Topeka, Kansas 66620

1. Location of well:		County McPHERSON	Fraction SE NW 1/4 NE 1/4 SE 1/4	Section number 31	Township number T 20 S	Range number R 3 W
2. Distance and direction from nearest town or city: Street address of well location if in city:		5 mi. So. OF McPHERSON		3. Owner of well: JACOB SCHRAL R.R. or street: RR I City, state, zip code: McPHERSON KS 67460		
4. Locate with "X" in section below:		Sketch map:		6. Bore hole dia. 30 in. Completion date 3-18 Well depth 208 ft. 77		
				7. Cable tool <input type="checkbox"/> Rotary <input type="checkbox"/> Driven <input type="checkbox"/> Dug <input type="checkbox"/> Hollow rod <input type="checkbox"/> Jetted <input type="checkbox"/> Bored <input checked="" type="checkbox"/> Reverse rotary		
5. Type and color of material				8. Use: Domestic <input type="checkbox"/> Public supply <input type="checkbox"/> Industry <input checked="" type="checkbox"/> Irrigation <input type="checkbox"/> Air conditioning <input type="checkbox"/> Stock <input type="checkbox"/> Lawn <input type="checkbox"/> Oil field water <input type="checkbox"/> Other		
				9. Casing: Material TRANSITE Weight: Above or below Threaded <input type="checkbox"/> Welded <input type="checkbox"/> Surface 12 in. RMP <input type="checkbox"/> PVC <input type="checkbox"/> Weight 32 lbs./ft. Dia. 16 in. to 208 ft. depth Wall Thickness: inches or Dia. <input type="checkbox"/> in. to <input type="checkbox"/> ft. depth gage No. 314		
				10. Screen: Manufacturer's name AURORA FILE CO. Type TRANSITE Dia. 16" I.D. Slot/gauze 1/8 Length 117 ft. Set between 104 ft. and 156 ft. and 208 ft. Gravel pack? yes Size range of material 1/4"		
				11. Static water level: <input type="checkbox"/> mo./day/yr. 47 ft. below land surface Date 3-18-77		
				12. Pumping level below land surfaces: ____ ft. after ____ hrs. pumping ____ g.p.m. ____ ft. after ____ hrs. pumping ____ g.p.m. Estimated maximum yield 1200 g.p.m.		
				13. Water sample submitted: <input type="checkbox"/> mo./day/yr. Yes <input checked="" type="checkbox"/> No <input type="checkbox"/> Date		
				14. Well head completion: Pump island Pitless adapter 12 inches above grade		
				15. Well grouted? yes Purified clay With: Neat cement <input type="checkbox"/> Bentonite <input type="checkbox"/> Concrete <input type="checkbox"/> Depth: From 0 ft. to 16 ft.		
				16. Nearest source of possible contamination: ft. 1200 Direction E Type Field Well disinfected upon completion? Yes <input checked="" type="checkbox"/> No <input type="checkbox"/>		
				17. Pump: Not installed Manufacturer's name WESTERN LAND RULER Model number 8m HP 60 Volts — Length of drop pipe 120 ft. capacity 1200 g.p.m. Type: <input type="checkbox"/> Submersible <input checked="" type="checkbox"/> Turbine <input type="checkbox"/> Jet <input type="checkbox"/> Reciprocating <input type="checkbox"/> Centrifugal <input type="checkbox"/> Other		
18. Elevation:		19. Remarks:		20. Water well contractor's certification: This well was drilled under my jurisdiction and this report is true to the best of my knowledge and belief. PETERSON IRRIGATION 138A Business name License No. Address Box 150 LINDSAY KS Signed Wally Peterson Date 4-21-77 Authorized representative		
Topography: <input checked="" type="checkbox"/> Hill <input type="checkbox"/> Slope <input type="checkbox"/> Upland <input type="checkbox"/> Valley		ALL SURFACE WATER DRAINS AWAY FROM WELL				

Forward the white, blue and pink copies to the Department of Health and Environment

Form WWC-5