

WATER WELL RECORD Form WWC-5

Original Record Correction Change in Well Use


Division of Water Resources App. No.

39205,47468, 46155

Well ID

1 LOCATION OF WATER WELL:
 County: McPherson Fraction SE 1/4 SE 1/4 SW 1/4 NE 1/4 Section Number 28 Township Number T 20 S Range Number R 3 E W

2 WELL OWNER: Last Name: Stucky First: Larry
 Business: Street or Rural Address where well is located (if unknown, distance and direction from nearest town or intersection): If at owner's address, check here:
 Address: 1528 Cimarron Rd. 61 Hwy & Comanche Rd. East to 15th 1/2S west into field
 Address: City: McPherson State: Ks. ZIP: 67460

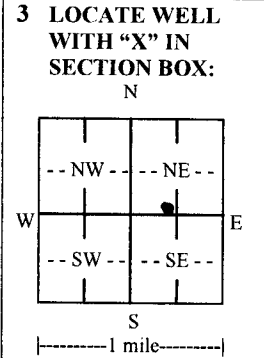

4 DEPTH OF COMPLETED WELL:100..... ft.
 Depth(s) Groundwater Encountered: 1) ft.
 2) ft. 3) ft., or 4) Dry Well
WELL'S STATIC WATER LEVEL:42..... ft.
 below land surface, measured on (mo-day-yr) 4/17/2019
 above land surface, measured on (mo-day-yr).....
 Pump test data: Well water was ft.
 after..... hours pumping gpm
 Well water was ft.
 after..... hours pumping gpm
 Estimated Yield:gpm
 Bore Hole Diameter:40..... in. to100..... ft. and
 in. to ft.

5 Latitude:38.28268.....(decimal degrees)
Longitude:097.65376.....(decimal degrees)
 Horizontal Datum: WGS 84 NAD 83 NAD 27
 Source for Latitude/Longitude:
 GPS (unit make/model: ..Garmin 62S.....)
 (WAAS enabled? Yes No)
 Land Survey Topographic Map
 Online Mapper:

6 Elevation: 1450.....ft. Ground Level TOC
 Source: Land Survey GPS Topographic Map
 Other

7 WELL WATER TO BE USED AS:

1. Domestic: Household Lawn & Garden Livestock
 Irrigation
 Feedlot
 Industrial

2. Public Water Supply: well ID

3. Dewatering: how many wells?

4. Aquifer Recharge: well ID

5. Monitoring: well ID

6. Environmental Remediation: well ID

7. Air Sparge Soil Vapor Extraction
 Recovery Injection

8. Oil Field Water Supply: lease

9. Test Hole: well ID

10. Cased Uncased Geotechnical

11. Geothermal: how many bores?

a) Closed Loop Horizontal Vertical
 b) Open Loop Surface Discharge Inj. of Water

12. Other (specify):

Was a chemical/bacteriological sample submitted to KDHE? Yes No If yes, date sample was submitted:

Water well disinfected? Yes No

8 TYPE OF CASING USED: Steel PVC Other CASING JOINTS: Glued Clamped Welded Threaded
 Casing diameter16..... in. to60..... ft., Diameter in. to ft., Diameter in. to ft.
 Casing height above land surface24..... in. WeightSCH40..... lbs./ft. Wall thickness or gauge No.500.....

TYPE OF SCREEN OR PERFORATION MATERIAL:
 Steel Stainless Steel Fiberglass PVC Other (Specify)

SCREEN OR PERFORATION OPENINGS ARE:
 Continuous Slot Mill Slot Gauze Wrapped Torch Cut Drilled Holes Other (Specify)

SCREEN-PERFORATED INTERVALS: From60..... ft. to100..... ft., From ft. to ft., From ft. to ft.
GRAVEL PACK INTERVALS: From100..... ft. to20..... ft., From ft. to ft., From ft. to ft.

9 GROUT MATERIAL: Neat cement Cement grout Bentonite Other

Nearest source of possible contamination:
 Septic Tank Lateral Lines Pit Privy Livestock Pens Insecticide Storage
 Sewer Lines Cess Pool Sewage Lagoon Fuel Storage Abandoned Water Well
 Watertight Sewer Lines Seepage Pit Feedyard Fertilizer Storage Oil Well/Gas Well
 Other (Specify)old irrigation well.....
 Direction from well?East..... Distance from well?120..... ft.

10 FROM	TO	LITHOLOGIC LOG	FROM	TO	LITHO. LOG (cont.) or PLUGGING INTERVALS
0	3	Top soil	80	90	Med. to fine sand w/clay pcs (clean)
3	15	Brown clay	90	98	Small & med. sand
15	20	Light brown clay	98	100	Green shale
20	30	Tan sandy clay			
30	38	Gray sandy clay mix 70/30			
38	54	Fine to small sand-tan clay mix 70/30			
54	54 1/2	Hard caliche	Notes:		
54 1/2	63	Small to fine sand			
63	80	Med. to small sand (clean)			

11 CONTRACTOR'S OR LANDOWNER'S CERTIFICATION: This water well was constructed, reconstructed, or plugged under my jurisdiction and was completed on (mo-day-year) 4/17/2019..... and this record is true to the best of my knowledge and belief. Kansas Water Well Contractor's License No. 134..... This Water Well Record was completed on (mo-day-year) 4/22/2019..... under the business name of Rosencrantz-Bemis Ent. Signature: C. J. Burrell