

WATER WELL PLUGGING RECORD Form WWC-5P

KSA 82a-1212

ID NO.

1 LOCATION OF WATER WELL: County: McPherson	Fraction ¼ NE ¼ NE ¼ NW ¼	Section Number 21	Township Number T 20 S	Range Number 3 <input type="checkbox"/> E <input checked="" type="checkbox"/> W
--	------------------------------	----------------------	---------------------------	--

Street/Rural Address of Well Location; if unknown, distance & direction from nearest town or intersection: If at owner's address, check here ☐ approximately 2 miles south and 1/2 mile east of McPherson, KS

Global Positioning Systems (GPS) information:

Latitude: 38.30419 (in decimal degrees)

Longitude: -97.65839 (in decimal degrees)

Elevation:

Horizontal Datum: ☐ WGS84, ☒ NAD83, ☐ NAD27

Collection Method:


2 WATER WELL OWNER: Bonnie Irons c/o Darren Irons
RR#, St. Address, Box #: 2001 Worthington Ln
City, State ZIP Code: Edmond, OK 73013

☒ GPS unit (Make/Model: Garmin GPSmap 60CSx

☐ Digital Map/Photo, ☐ Topographic Map, ☐ Land Survey

Est. Accuracy: ☐ < 3 m, ☒ 3-5 m, ☐ 5-15 m, ☐ > 15 m

3 MARK WELL'S LOCATION WITH AN "X" IN SECTION BOX:

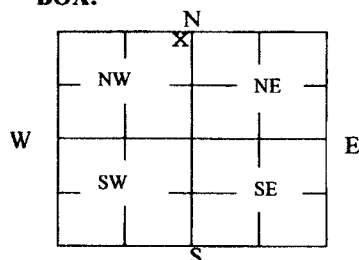

4 DEPTH OF WELL 96.4 ft.

WELL'S STATIC WATER LEVEL 60.98 ft

WELL WAS USED AS:

- ☒ Domestic
☐ Irrigation
☐ Feedlot
☐ Industrial

- ☐ Public Water Supply
☐ Oil Field Water Supply
☐ Domestic (Lawn & Garden)
☐ Air Conditioning

- ☐ Dewatering
☐ Monitoring
☐ Injection Well
☐ Other

Was a chemical/bacteriological sample submitted to Department? Yes ☐ No ☒

5 TYPE OF BLANK CASING USED:

- ☐ Steel ☐ RMP (SR) ☐ Wrought ☐ Fiberglass ☐ Other (Specify below)
☒ PVC ☐ ABS ☐ Asbestos-Cement ☐ Concrete Tile

Blank casing diameter 5 in. Was casing pulled? Yes ☐ No ☒ If yes, how much
Casing height above or below land surface below 36 in.

6 GROUT PLUG MATERIAL: ☐ Neat cement ☐ Cement grout ☒ Bentonite ☐ Other

Grout Plug Intervals: From 60.98 ft. to 3 ft., From ft. to ft., From ft. to ft.

What is the nearest source of possible contamination:

- ☐ Septic tank ☐ Seepage pit ☒ Fuel storage ☐ Other (specify below)
☐ Sewer lines ☐ Pit privy ☐ Fertilizer storage
☐ Watertight sewer lines ☐ Sewage lagoon ☐ Insecticide storage
☐ Lateral lines ☐ Feedyard ☐ Abandoned water well
☐ Cess pool ☐ Livestock pens ☐ Oil well/Gas well

Direction from well? northeast
How many feet? approximately 400 ft

FROM	TO	PLUGGING MATERIALS	FROM	TO	PLUGGING MATERIALS
96.4	60.98	Clean, coarse sand			
60.98	3	Bentonite Chips			
3	0	Topsoil			

Well plugging witnessed by

D. Randolph, GMD2 staff, on 4/16/2020

7 CONTRACTOR'S OR LANDOWNER'S CERTIFICATION: This water well was plugged under my jurisdiction and was completed on (mo/day/year) 4/16/2020 and this record is true to the best of my knowledge and belief. Kansas Water Well Contractor's License No. This Water Well Record was completed on (mo/day/year) 4/17/2020 under the business name of by (signature)

Send one white copy to Kansas Department of Health & Environment, Geology Section, 1000 SW Jackson Street, Ste. 420, Topeka, KS 66612-1367. Send one copy to WATER WELL OWNER and retain one for your records.

Visit us at <http://www.kdheks.gov/waterwell/index.html> Telephone 785-296-5524

KSA82a-1212

Revised 1/20/2015