


1 LOCATION OF WATER WELL:	Fraction	Section Number	Township Number	Range Number
County: <u>McPherson</u>	SW 1/4 NW 1/4 NW 1/4	18	T 20 S	R 3 E/W

Distance and direction from nearest town or city street address of well if located within city?

From corner of 153 and 56 Hiways 1 Mile West and 3 3/4 Miles South

2] WATER WELL OWNER: Rodney J. Swanson		
RR#, St. Address, Box # :	RR # 1	Board of Agriculture, Division of Water Resources
City, State, ZIP Code :	McPherson, Kansas 67460	Application Number:

3. LOCATE WELL'S LOCATION WITH AN "X" IN SECTION BOX:  4. DEPTH OF COMPLETED WELL: 83' 0" ft. ELEVATION: _____ ft.
Depth(s) Groundwater Encountered 1. 49' 3" Not Weight _____ ft. 3. _____ ft.

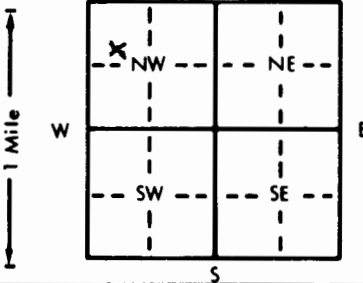

4 DEPTH OF COMPLETED WELL .83' 10" ft. ELEVATION:
 Depth(s) Groundwater Encountered 1.49' 3" ft. 3. ft.
 WELL'S STATIC WATER LEVEL ft. below land surface measured on mo/day/yr
 Pump test data: Well water was ft. after hours pumping gpm
 Est. Yield gpm: Well water was ft. after hours pumping gpm
 Bore Hole Diameter in. to ft., and in. to ft.
 WELL WATER TO BE USED AS: 5 Public water supply 8 Air conditioning 11 Injection well
 1 Domestic 3 Feedlot 6 Oil field water supply 9 Dewatering 12 Other (Specify below)
 2 Irrigation 4 Industrial 7 Lawn and garden only 10 Monitoring well
 Was a chemical/bacteriological sample submitted to Department? Yes No ☒; If yes, mo/day/yr sample was sub
 mitted Water Well Disinfected? Yes ☒ No

5	TYPE OF BLANK CASING USED:		5 Wrought iron	8 Concrete tile	CASING JOINTS: Glued Clamped Welded Threaded
	1 Steel	3 RMP (SR)	6 Asbestos-Cement	9 Other (specify below)	
	2 PVC	4 ABS	7 Fiberglass		
	Blank casing diameter 6" in. to ft., Dia in. to ft., Dia in. to ft.				

Casing height above land surface 0 in., weight lbs./ft. Wall thickness or gauge No.

TYPE OF SCREEN OR PERFORATION MATERIAL:

1 Steel	3 Stainless steel	5 Fiberglass	7 PVC	10 Asbestos-cement
2 Brass	4 Galvanized steel	6 Concrete tile	8 RMP (SR)	11 Other (specify) . . . <i>NA</i>
			9 ABS	12 None used (open hole)

SCREEN OR PERFORATION OPENINGS ARE:

1 Continuous slot	3 Mill slot	5 Gauzed wrapped	8 Saw cut	11 None (open hole)
2 Louvered shutter	4 Key punched	6 Wire wrapped	9 Drilled holes	
		7 Torch cut	10 Other (specify) <i>NA</i>	

SCREEN-PERFORATED INTERVALS:	From <u>NA</u>	ft. to <u>NA</u>	ft., From	ft. to	ft.
	From	ft. to	ft., From	ft. to	ft.
GRAVEL PACK INTERVALS:	From	ft. to	ft., From	ft. to	ft.
	From	ft. to	ft., From	ft. to	ft.

6 GROUT MATERIAL: 1 Neat cement 2 Cement grout 3 Bentonite 4 Other
Grout Intervals: From 30 ft. to 26 ft. From 26 ft. to 2.5 ft. From ft. to ft.
What is the nearest source of possible contamination:
1 Septic tank 4 Lateral lines 7 Pit privy 10 Livestock pens 14 Abandoned water well
2 Sewer lines 5 Cess pool 8 Sewage lagoon 11 Fuel storage 15 Oil well/Gas well
3 Watertight sewer lines 6 Seepage pit 9 Feedyard 12 Fertilizer storage 16 Other (specify below)
13 Insecticide storage
Direction from well? How many feet?

[illegible]

7 CONTRACTOR'S OR LANDOWNER'S CERTIFICATION: This water well was (1) constructed, (2) reconstructed, or (3) plugged under my jurisdiction and was completed on (mo/day/year) 12-1-94 and this record is true to the best of my knowledge and belief. Kansas Water Well Contractor's License No. [REDACTED] This Water Well Record was completed on (mo/day/yr) 12-6-94 under the business name of Board of Public Utilities by (signature) *Frank D. Halligan*