

MW-9

2211026

WATER WELL RECORD

Form WWC-5

KSA 82a-1212

1 LOCATION OF WATER WELL:	Fraction	Section Number	Township Number	Range Number
County: <u>McPherson</u> ⁶⁵⁹	<u>NW</u> $\frac{1}{4}$ <u>SW</u> $\frac{1}{4}$ <u>NW</u> $\frac{1}{4}$	<u>4</u>	T <u>20</u> S	R <u>3</u> EW

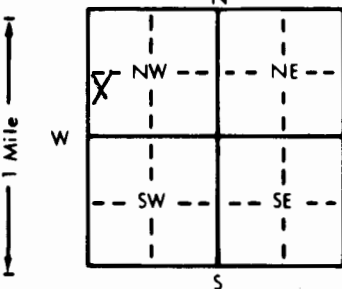
Distance and direction from nearest town or city street address of well if located within city?

3320' N & 508' E of SE Corner Section 5

2 WATER WELL OWNER:	Board of Agriculture, Division of Water Resources
RR#, St. Address, Box #:	Application Number:
City, State, ZIP Code:	

KDHE
Forbes Field, Bldg 740
Topeka KS 66620-0001

3 LOCATE WELL'S LOCATION WITH AN "X" IN SECTION BOX:	4 DEPTH OF COMPLETED WELL: <u>93</u> ft. ELEVATION:
--	---

Depth(s) Groundwater Encountered 1. 78 ft. 2. ft. 3. ft.

WELL'S STATIC WATER LEVEL . . . ft. below land surface measured on mo/day/yr

Pump test data: Well water was . . . ft. after . . . hours pumping . . . gpm

Est. Yield . . . gpm: Well water was . . . ft. after . . . hours pumping . . . gpm

Bore Hole Diameter: 8 in. to . . . ft., and . . . in. to . . . ft.

WELL WATER TO BE USED AS:

1 Domestic	3 Feedlot	6 Oil field water supply	9 Dewatering	12 Other (Specify below)
2 Irrigation	4 Industrial	7 Lawn and garden only	<u>10 Monitoring well</u>	

Was a chemical/bacteriological sample submitted to Department? Yes . . . No X . . . If yes, mo/day/yr sample was submittedWater Well Disinfected? Yes . . . No X

5 TYPE OF BLANK CASING USED:	5 Wrought iron	8 Concrete tile	CASING JOINTS: Glued . . . Clamped . . .
1 Steel	3 RMP (SR)	6 Asbestos-Cement	9 Other (specify below)
<u>2 PVC</u>	4 ABS	7 Fiberglass	Welded . . .
			<u>Threaded. Flush</u>

Blank casing diameter 2 in. to . . . ft., Dia. . . in. to . . . ft., Dia. . . in. to . . . ft.Casing height above land surface 36 in., weight 703 lbs./ft. Wall thickness or gauge No. 154

TYPE OF SCREEN OR PERFORATION MATERIAL:

1 Steel	3 Stainless steel	5 Fiberglass	8 RMP (SR)	10 Asbestos-cement
2 Brass	4 Galvanized steel	6 Concrete tile	9 ABS	11 Other (specify)
				12 None used (open hole)

SCREEN OR PERFORATION OPENINGS ARE:

1 Continuous slot	<u>3 Mill slot</u>	5 Gauzed wrapped	8 Saw cut	11 None (open hole)
2 Louvered shutter	4 Key punched	6 Wire wrapped	9 Drilled holes	
		7 Torch cut	10 Other (specify)	

SCREEN-PERFORATED INTERVALS: From 73 ft. to 92.5 ft., From . . . ft. to . . . ft.

From . . . ft. to . . . ft., From . . . ft. to . . . ft.

GRAVEL PACK INTERVALS: From 69 ft. to 92.5 ft., From . . . ft. to . . . ft.

From . . . ft. to . . . ft., From . . . ft. to . . . ft.

6 GROUT MATERIAL:	1 Neat cement	2 Cement grout	<u>3 Bentonite</u>	<u>4 Other</u> <u>concrete</u>
Grout Intervals: From <u>69</u> ft. to . . . ft., From <u>4</u> ft. to . . . ft., From . . . ft. to . . . ft.				

What is the nearest source of possible contamination:

1 Septic tank	4 Lateral lines	7 Pit privy	10 Livestock pens	14 Abandoned water well
2 Sewer lines	5 Cess pool	8 Sewage lagoon	11 Fuel storage	15 Oil well/Gas well
3 Watertight sewer lines	6 Seepage pit	9 Feedyard	12 Fertilizer storage	16 Other (specify below)
			13 Insecticide storage	

Direction from well?

How many feet?

FROM	TO	LITHOLOGIC LOG	FROM	TO	PLUGGING INTERVALS
0.0	8.0	Silt clay			
8.0	9.0	Sand			
9.0	20.0	Clay, silt			
20.0	40.5	Silt, clay			
40.5	44.5	Silt			
44.5	50.0	Silt			
50.0	63.0	Sand			
63.0	78.0	Silt clay			
78.0	93.0	Silty sand			

7 CONTRACTOR'S OR LANDOWNER'S CERTIFICATION: This water well was (1) constructed, (2) reconstructed, or (3) plugged under my jurisdiction and was completed on (mo/day/year) <u>1-5-95</u> and this record is true to the best of my knowledge and belief. Kansas Water Well Contractor's License No. <u>531</u> This Water Well Record was completed on (mo/day/yr) <u>1-30-95</u> under the business name of <u>GSI</u> by (signature) <u>Allison Irwin</u>

INSTRUCTIONS: Use typewriter or ball point pen. PLEASE PRESS FIRMLY and PRINT clearly. Please fill in blanks, underline or circle the correct answers. Send top three copies to Kansas Department of Health and Environment, Bureau of Water, Topeka, Kansas 66620-0001. Telephone: 913-296-5545. Send one to WATER WELL OWNER and retain one for your records.