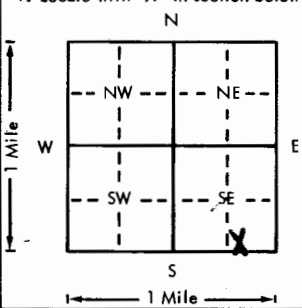


USE TYPEWRITER OR BALL
POINT PEN-PRESS FIRMLY,
PRINT CLEARLY.

WATER WELL RECORD
KSA 82a-1201-1215

Kansas Department of Health and
Environment-Division of Environment
(Water well Contractors)
Topeka, Kansas 66620

1. Location of well:		County <u>LANE</u> <u>Lawrence</u>	Fraction 1/4 1/4 <u>SE</u> 1/4	Section number <u>32</u>	Township number <u>20</u> S	Range number <u>30</u> E
2. Distance and direction from nearest town or city: Street address of well location if in city:			3. Owner of well: <u>Carl Plummer</u> R.R. or street: City, state, zip code: <u>Carden City, KS.</u>			
4. Locate with "X" in section below:		Sketch map:		6. Bore hole dia. <u>9 1/2</u> in. Completion date: <u>4-4-80</u> Well depth <u>90</u> ft.		
		<u>corns</u> <u>Xwell</u> <u>pasture</u>		7. Cable tool <input checked="" type="checkbox"/> Rotary <input type="checkbox"/> Driven <input type="checkbox"/> Dug Hollow rod <input type="checkbox"/> Jetted <input type="checkbox"/> Bored <input type="checkbox"/> Reverse rotary		
5. Type and color of material		From		To		8. Use: Domestic <input type="checkbox"/> Public supply <input type="checkbox"/> Industry <input type="checkbox"/> Irrigation <input type="checkbox"/> Air conditioning <input checked="" type="checkbox"/> Stock <input type="checkbox"/> Lawn <input type="checkbox"/> Oil field water <input type="checkbox"/> Other <input type="checkbox"/>
<u>Fine Sand</u>		<u>0</u>		<u>10</u>		9. Casing: Material <u>PITS</u> Height <u>Above</u> or below Threaded <input type="checkbox"/> Welded <input checked="" type="checkbox"/> Surface <u>18</u> in. RMP <input type="checkbox"/> PVC <input type="checkbox"/> Weight <u>91</u> lbs./ft. Dia. <u>5</u> in. to <u>50</u> ft. depth Wall Thickness: inches Dia. <u>5</u> in. to <u>80</u> ft. depth Gauge No. <u>3440</u>
<u>Brown Sandy clay</u>		<u>10</u>		<u>50</u>		10. Screen: Manufacturer's name <u>Pitless</u> Type <u>PITS</u> Dia. <u>5</u> in. Slot/size <u>30</u> Length <u>30</u> ft. Set between <u>50</u> ft. and <u>70</u> ft. ft. and <u>90</u> ft. Gravel pack? <u>no</u> Size range of material
<u>Fine Sand</u>		<u>50</u>		<u>60</u>		11. Static water level: <u>51</u> ft. below land surface Date <u>4-4-80</u> mo./day/yr.
<u>Brown Sandy clay</u>		<u>60</u>		<u>80</u>		12. Pumping level below land surfaces: ft. after <u> </u> hrs. pumping <u> </u> g.p.m. ft. after <u> </u> hrs. pumping <u> </u> g.p.m. Estimated maximum yield <u> </u> g.p.m.
<u>Fine Sand</u>		<u>80</u>		<u>90</u>		13. Water sample submitted: <u> </u> mo./day/yr. Yes <input type="checkbox"/> No <input checked="" type="checkbox"/> Date
						14. Well head completion: Pitless adapter <u>18</u> inches above grade
						15. Well grouted? <input checked="" type="checkbox"/> With: <input checked="" type="checkbox"/> Neat cement <input type="checkbox"/> Bentonite <input type="checkbox"/> Concrete Depth: From <u>0</u> ft. to <u>20</u> ft.
						16. Nearest source of possible contamination: ft. <u>NE</u> Direction <u>50</u> Type <u>Septic</u> Well disinfected upon completion? Yes <input type="checkbox"/> No <input checked="" type="checkbox"/>
						17. Pump: Manufacturer's name <u> </u> Model number <u> </u> HP <u> </u> Volts <u> </u> Length of drop pipe <u> </u> ft. capacity <u> </u> g.p.m. Type: <input type="checkbox"/> Submersible <input type="checkbox"/> Turbine <input type="checkbox"/> Jet <input checked="" type="checkbox"/> Reciprocating <input type="checkbox"/> Centrifugal <input type="checkbox"/> Other
18. Elevation:		19. Remarks:		20. Water well contractor's certification: This well was drilled under my jurisdiction and this report is true to the best of my knowledge and belief. <u>Jonas Dely</u> <u>172</u> Business name <u> </u> License No. <u> </u> Address <u> </u> Signed <u> </u> Date <u> </u> Authorized representative		
Topography: <input type="checkbox"/> Hill <input type="checkbox"/> Slope <input type="checkbox"/> Upland <input checked="" type="checkbox"/> Valley		<u>Finished himself</u>				

Forward the white, blue and pink copies to the Department of Health and Environment

Form WWC-5