


AMK SW

2031W26BB A
T R EW sec 1/4 1/4 1/4 No.

WATER WELL RECORD
KSA 82a-1201-1215

Kansas State Dept. Of Health
(Water Well Contractors)
Forbes-Bldg. 740
Topeka, Kansas 66620

BBC

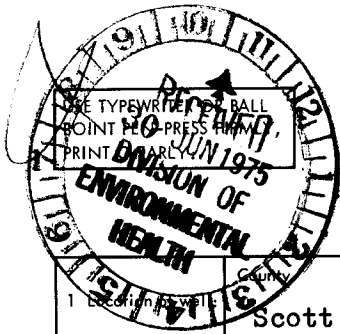


County Scott	Township name Lake	Fraction SW NW 1/4 NW 1/4	Section number 26	Town number 20S	Range number 31W
-----------------	-----------------------	------------------------------	----------------------	--------------------	---------------------

Distance and direction from nearest town or city: **13 mi south of Grigston**

Street address of well location if in city: **Grigston**

3 Owner of well: **Richard Van Campen**
Address: **Rte #2, Scott City, Ks. 67871**

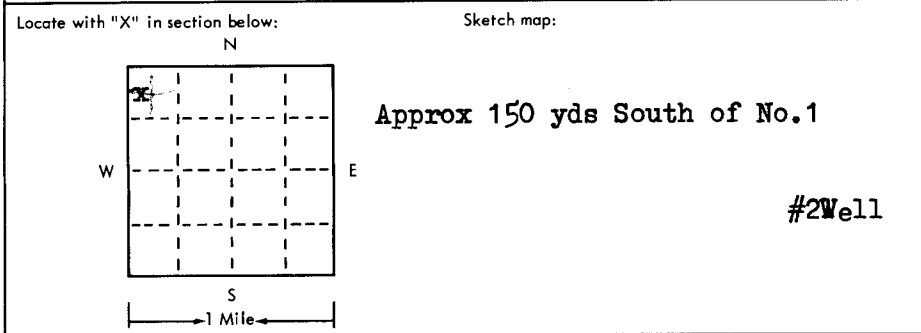

4 Well depth: 132 ft. Date of completion 6/24/75
Well diameter 2 1/4 in.

5 Cable tool Rotary Driven Dug
 Hollow rod Jetted Bored Reverse rotary

6 Use: Domestic Public supply Industry
 Irrigation Air conditioning Commercial
 Test well

7 Casing: Material Steel Height: above/below
Threaded Welded Surface 72 in.
Diam. 12 Weight 1.59 lbs/ft
12 in. to 132 ft. depth Drive shoe? Yes No
___ in. to ___ ft. depth

2	Type and color of material	From	To
	Sandy clay	1	20
	Clay	20	40
	Clay, sand	40	60
	Clay, sand	60	80
	Clay	80	100
	Clay	100	120
	Clay, shale	120	140
	BROCK 130'		
	week		
	To be planted first of July if possible		
	(use a second sheet if needed)		

8 Screen:
Manufacturer W A Brown Enterprises
Type FreeFlo Dia. 12
Slot/gauze 1/8 Length 2"
Set between 32 ft. and 132 ft.
Fittings: 1 x 5/8 fine
Gravel pack Yes No Size range of material ___

9 Static water level:
35 ft. below land surface Date 6-24-75

10 Pumping level below land surfaces:
___ ft. after ___ hrs. pumping ___ g.p.m.
___ ft. after ___ hrs. pumping ___ g.p.m.
Estimated maximum yield 150 g.p.m.

11 Water sample submitted:
 Yes No Date ___

12 Well head completion:
 Pitless adapter Inches above grade

13 Well grouted? Yes No
 Neat cement Bentonite ___
Depth: From 0 ft. to 10 ft.

14 Nearest source of possible contamination: NA
ft. ___ Direction ___ Type ___
Well disinfected upon completion? Yes No

15 Pump: Not installed
Manufacturer's name Goulds
Model number UH66-KMA2 Volts 240
Length of drop pipe 129 ft. capacity 170 g.m.p.
Type:
 Submersible Turbine
 Jet Reciprocating
 Centrifugal Other

16 Remarks: elevation 2879 (TOPO)

Topography:
 Hill
 Slope
 Upland **Level**
 Valley

High Plains Drilling & Supply, Inc

17 Water well contractor's certification:
This well was drilled under my jurisdiction and this report is true to the best of my knowledge and belief.

High Plains Drilling & Supply, Inc License No. 136
Business name
Address 102 N 3rd, Garden City, Ks.
Signed Shirley E. Johnson Date 6-26-75
Authorized representative
S. W. Treas.