


WATER WELL RECORD Form WWC-5 KSA 82a-1212

1 LOCATION OF WATER WELL: Fraction SW 1/4 SW 1/4 NE 1/4 Section Number 19 Township Number T 20 S Range Number R 32 W
 COUNTY: 086 SCOTT

Distance and direction from nearest town or city street address of well if located within city?
 FROM FRIEND; 1/4 NORTH, 2 EAST, 3 NORTH, 1/2 EAST, 1/2 SOUTH

2 WATER WELL OWNER: POKY FEEDERS INC.
 RR#, St. Address, Box #: 600 E RD 3030 Board of Agriculture, Division of Water Resources
 City, State, ZIP code: SCOTT CITY, KS 67871-9412 Application Number: 13938

3 LOCATE WELL'S LOCATION WITH AN "X" IN SECTION BOX:

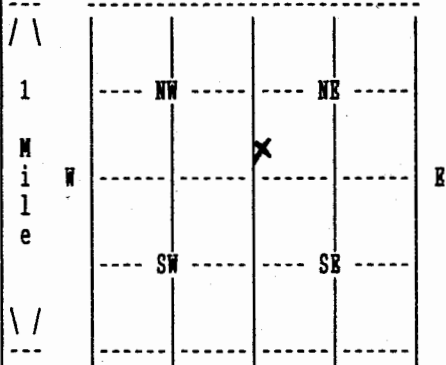

4 DEPTH OF COMPLETED WELL 142 ELEVATION: 0
 Depth(s) Groundwater Encountered 1. 0 ft. 2. 0 ft. 3. 0 ft.

WELL'S STATIC WATER LEVEL 102 ft. below land surface measured on mo/day/yr 10/06/04
 Pump test data: Well water was 0 ft. after 0 hours pumping 0 gpm

Estimated Yield 0 gpm: Well water was 0 ft. after 0 hours pumping 0 gpm

Bore Hole Diameter in. to 0 ft., and in. to 0 ft.

WELL WATER WAS: 02 IRRIGATION

Was a chemical/bacteriological sample submitted to department? No ;
 If yes, mo/day/yr sample was submitted Water well disinfected? Yes

5 TYPE OF BLANK CASING USED: 01 STEEL CASING JOINTS: CLAMPED
 Blank casing diameter 16 in. to 142 ft., Dia in. to 0 ft., Dia in. to 0 ft.
 Casing height above land surface -36 in., weight 0 lbs/ft. Wall thickness or gauge No.
 TYPE OF SCREEN OR PERFORATION MATERIAL: 01 STEEL
 SCREEN OR PERFORATION OPENINGS ARE: UNKNOWN

SCREEN PERFORATED INTERVALS: From 0 ft. to 0 ft., From 0 ft. to 0 ft.
 From 0 ft. to 0 ft., From 0 ft. to 0 ft.
 GRAVEL PACK INTERVALS: From 0 ft. to 0 ft., From 0 ft. to 0 ft.
 From 0 ft. to 0 ft., From 0 ft. to 0 ft.

6 GROUT MATERIAL 02 CEMENT GROUT
 Grout Intervals: From 3 ft. to 142 ft., From 0 ft. to 0 ft., From 0 ft. to 0 ft.
 What is the nearest source of possible contamination: NONE OBSERVED
 Direction from well? How many feet? 0

FROM	TO	LITHOLOGIC LOG	FROM	TO	PLUGGING INTERVALS
			0	3	BACKFILL
			3	142	CEMENT
			0	0	
			0	0	
			0	0	
			0	0	
			0	0	
			0	0	
			0	0	

7 CONTRACTOR'S OR LANDOWNER'S CERTIFICATION: This water well was Plugged under my jurisdiction and was completed on (mo/day/year) 10/06/04 and this record is true to the best of my knowledge and belief. Kansas Water Well Contractor's License No. 145 This Water Well Record was completed on (mo/day/yr) 10/12/04 under the business name of HENKLE DRILLING & SUPPLY by (signature) Bruce J. Reichman