


WATER WELL RECORD Form WWC-5 KSA 82a-1212

1 LOCATION OF WATER WELL: Fraction Section Number Township Number Range Number
 COUNTY: 086 SCOTT NW 1/4 NE 1/4 SE 1/4 19 T 20 S R 32 W

Distance and direction from nearest town or city street address of well if located within city?
 FROM SHALLOW WATER' APPX 5 MILES SOUTH & 1 MILE EAST

2 WATER WELL OWNER: POKY FEEDERS, INC.
 RR#, St. Address, Box #: RT 2 BOX 168 Board of Agriculture, Division of Water Resources
 City, State, ZIP code: SCOTT CITY, KS 67871-9412 Application Number: 13,938

3 LOCATE WELL'S LOCATION WITH AN "X" IN SECTION BOX:

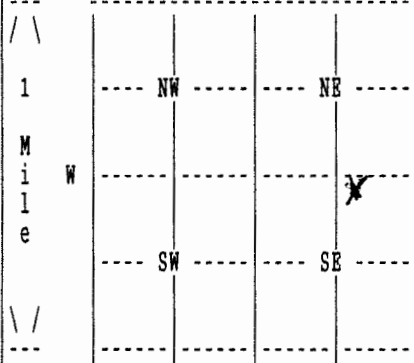

4 DEPTH OF COMPLETED WELL 156 ELEVATION: 0
 Depth(s) Groundwater Encountered 1. 0 ft. 2. 0 ft. 3. 0 ft.

WELL'S STATIC WATER LEVEL 96 ft. below land surface measured on mo/day/yr 03/04/05
 Pump test data: Well water was 118 ft. after 4 hours pumping 60 gpm

Estimated Yield 0 gpm: Well water was 0 ft. after 0 hours pumping 0 gpm

Bore Hole Diameter 17.5 in. to 156 ft., and in. to 0 ft.

WELL WATER TO BE USED AS: 03 FEEDLOT

Was a chemical/bacteriological sample submitted to department? No ;
 If yes, mo/day/yr sample was submitted Water well disinfected? Yes

5 TYPE OF BLANK CASING USED: 02 PVC CASING JOINTS: GLURD
 Blank casing diameter 8 5/8 in. to 156 ft., Dia in. to 0 ft., Dia in. to 0 ft.
 Casing height above land surface 12 in., weight 7 lbs/ft. Wall thickness or gauge No. .411
 TYPE OF SCREEN OR PERFORATION MATERIAL: 07 PVC
 SCREEN OR PERFORATION OPENINGS ARE: 03 MILL SLOT

SCREEN PERFORATED INTERVALS: From 96 ft. to 136 ft., From 0 ft. to 0 ft.
 From 0 ft. to 0 ft., From 0 ft. to 0 ft.
 GRAVEL PACK INTERVALS: From 25 ft. to 156 ft., From 0 ft. to 0 ft.
 From 0 ft. to 0 ft., From 0 ft. to 0 ft.

6 GROUT MATERIAL 03 BENTONITE
 Grout Intervals: From 5 ft. to 25 ft., From 0 ft. to 0 ft., From 0 ft. to 0 ft.
 What is the nearest source of possible contamination: NONE OBSERVED
 Direction from well? How many feet? 0

FROM	TO	LITHOLOGIC LOG	FROM	TO	PLUGGING INTERVALS
0	2	02 SILT			
2	18	04 SANDY CLAY			
18	35	05 SAND			
35	63	01 CLAY			
63	70	07 FINE SAND 08 MEDIUM SAND 04 SANDY CLAY			
70	97	01 CLAY 20 LIMESTONE			
97	104	04 SANDY CLAY			
104	120	07 FINE SAND 20 LIMESTONE			
120	136	07 FINE SAND 28 ROCK			
136	172	31 CALICHE			

7 CONTRACTOR'S OR LANDOWNER'S CERTIFICATION: This water well was Constructed under my jurisdiction and was completed on (mo/day/year) 02/18/05 and this record is true to the best of my knowledge and belief. Kansas Water Well Contractor's License No. 145 This Water Well Record was completed on (mo/day/yr) 03/30/05 under the business name of HENKLE DRILLING & SUPPLY by (signature)

(Continued)

WATER WELL RECORD Form WWC-5 KSA 82a-1212

1 LOCATION OF WATER WELL: COUNTY: 086 SCOTT	Fraction NW 1/4 NE 1/4 SE 1/4	Section Number 19	Township Number T 20 S	Range Number R 32 W
--	----------------------------------	----------------------	---------------------------	------------------------

2 WATER WELL OWNER: POKY FEEDERS, INC.
RR#, St. Address, Box # : RT 2 BOX 168
City, State, ZIP code : SCOTT CITY, KS 67871-9412

Board of Agriculture, Division of Water Resources
Application Number: 13,938

FROM	TO	LITHOLOGIC LOG
172	182	01 CLAY

7 CONTRACTOR'S OR LANDOWNER'S CERTIFICATION: This water well was Constructed under my jurisdiction and was completed on (mo/day/year) 02/18/05 and this record is true to the best of my knowledge and belief. Kansas Water Well Contractor's License No. 145 This Water Well Record was completed on (mo/day/yr), 03/30/05 under the business name of HENKLE DRILLING & SUPPLY by (signature)

