

WATER WELL PLUGGING RECORD Form WWC-5P

KSA 82a-1212

ID NO.


546

1 LOCATION OF WATER WELL: County: <u>Scott</u>	Fraction <u>1/4 1/4 1/4 NW 1/4</u>	Section Number <u>19</u>	Township Number <u>T 20 S</u>	Range Number <u>32</u> <input type="checkbox"/> E <input checked="" type="checkbox"/> W
--	---------------------------------------	-----------------------------	----------------------------------	--

Street/Rural Address of Well Location; if unknown, distance & direction from nearest town or intersection: If at owner's address, check here From Finney/Scott Co. line on Hwy 83,
2.8 miles north on 83 then aprox. 1/4 mile east on farm path

2 WATER WELL OWNER: John Fairleigh
RR#, St. Address, Box #: 311 W Road 250
City, State ZIP Code: Scott City Ks. 678710560

Global Positioning Systems (GPS) information:
Latitude: 38.30317 N (in decimal degrees)
Longitude: 100.90298 W (in decimal degrees)
Elevation: _____
Datum: WGS84, NAD83, NAD27
Collection Method:
 GPS unit (Make/Model: Magellon Triton)
 Digital Map/Photo, Topographic Map, Land Survey
Est. Accuracy: < 3 m, 3-5 m, 5-15 m, > 15 m

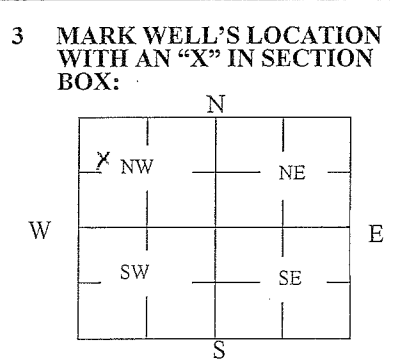

4 DEPTH OF WELL 158 ft.
WELL'S STATIC WATER LEVEL 131 ft.
WELL WAS USED AS:
 Domestic Public Water Supply Dewatering
 Irrigation Oil Field Water Supply Monitoring
 Feedlot Domestic (Lawn & Garden) Injection Well
 Industrial Air Conditioning Other _____
Was a chemical/bacteriological sample submitted to Department? Yes No

5 TYPE OF BLANK CASING USED:
 Steel RMP (SR) Wrought Fiberglass Other (Specify below)
 PVC ABS Asbestos-Cement Concrete Tile _____
Blank casing diameter 16 in. Was casing pulled? Yes No If yes, how much 54"
Casing height above or below land surface 54" below in.

6 GROUT PLUG MATERIAL: Neat cement Cement grout Bentonite Other _____
Grout Plug Intervals: From 4' 6" ft. to 9 ft., From _____ ft. to _____ ft., From _____ to _____ ft.
What is the nearest source of possible contamination:
 Septic tank Seepage pit Fuel Storage Other (specify below)
 Sewer lines Pit privy Fertilizer storage None Observed
 Watertight sewer lines Sewage lagoon Insecticide storage
 Lateral lines Feedyard Abandoned water well Direction from well? _____
 Cess pool Livestock pens Oil well/Gas well How many feet? _____

FROM	TO	PLUGGING MATERIALS	FROM	TO	PLUGGING MATERIALS
158'	131'	Chlorinated Road Sand	131'	9'	Dirty Oversized rock w/clay chunks
9'	4' 6"	3,000 PSI Concrete	4' 6"	0'	Dug down, cut off casing, backfill

7 CONTRACTOR'S OR LANDOWNER'S CERTIFICATION: This water well was plugged under my jurisdiction and was completed on (mo/day/year) 11-23-2011 and this record is true to the best of my knowledge and belief. Kansas Water Well Contractor's License No. 145. This Water Well Record was completed on (mo/day/year) 11-23-2011 under the business name of Hydro Resources Mid Continent by (signature) Gary Clepper

INSTRUCTIONS: Use typewriter or ballpoint pen. Please press firmly and print clearly. Please fill in blanks, underline or circle the correct answers. Send top three copies to Kansas Department of Health and Environment, Bureau of Water, Geology Section, 1000 SW Jackson St., Ste. 420, Topeka, Kansas 66612-1367. Telephone: 785/296-5524. Send one to Water Well Owner and retain one for your records. Visit us at <http://www.kdheks.gov/waterwell/index.html>.

Check one: White Copy Blue Copy Pink Copy