


WATER WELL RECORD Form WWC-5 KSA 82a-1212

1 LOCATION OF WATER WELL: Fraction Section Number Township Number Range Number
 COUNTY: 086 SCOTT NW 1/4 NW 1/4 SW 1/4 13 T 20 S R 33 W

Distance and direction from nearest town or city street address of well if located within city?
 APPROX. 3 1/2 MILES SOUTH & 1 MILES WEST OF SHALLOW WATER

2 WATER WELL OWNER: CRIST FREEDYARD INC
 RR#, St. Address, Box #: 553 W ROAD 40 Board of Agriculture, Division of Water Resources
 City, State, ZIP code: SCOTT CITY, KS 67871-5038 Application Number: 3,037 SC98

3 LOCATE WELL'S LOCATION WITH AN "X" IN SECTION BOX:

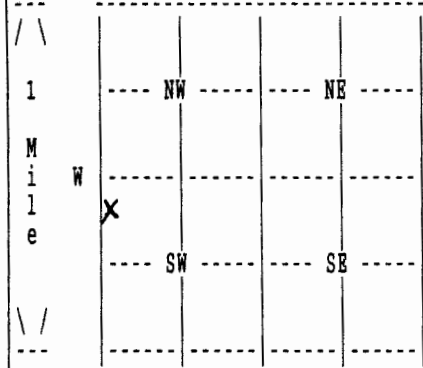

4 DEPTH OF COMPLETED WELL 180' ELEVATION: 0
 Depth(s) Groundwater Encountered 1. 0 ft. 2. 0 ft. 3. 0 ft.

WELL'S STATIC WATER LEVEL 140 ft. below land surface measured on mo/day/yr 11/30/05
 Pump test data: Well water was 0 ft. after 0 hours pumping 0 gpm
 Estimated Yield 0 gpm: Well water was 0 ft. after 0 hours pumping 0 gpm
 Bore Hole Diameter in. to 0 ft., and in. to 0 ft.
 WELL WATER WAS: 02 IRRIGATION

Was a chemical/bacteriological sample submitted to department? No ;
 If yes, mo/day/yr sample was submitted Water well disinfected? Yes

5 TYPE OF BLANK CASING USED: 01 STEEL CASING JOINTS: WELDED
 Blank casing diameter 16 in. to 180 ft., Dia in. to 0 ft., Dia in. to 0 ft.
 Casing height above land surface -48 in., weight 0 lbs/ft. Wall thickness or gauge No.
 TYPE OF SCREEN OR PERFORATION MATERIAL: 01 STEEL
 SCREEN OR PERFORATION OPENINGS ARE: UNKNOWN

SCREEN PERFORATED INTERVALS: From 0 ft. to 0 ft., From 0 ft. to 0 ft.
 GRAVEL PACK INTERVALS: From 0 ft. to 0 ft., From 0 ft. to 0 ft.
 From 0 ft. to 0 ft., From 0 ft. to 0 ft.

6 GROUT MATERIAL 02 CEMENT GROUT
 Grout intervals: From 4 ft. to 19 ft., From 0 ft. to 0 ft., From 0 ft. to 0 ft.
 What is the nearest source of possible contamination: IRRIGATION WELL
 Direction from well? NORTH How many feet? 101

FROM	TO	LITHOLOGIC LOG	FROM	TO	PLUGGING INTERVALS
			0	4	BACKFILL
			4	19	CEMENT
			19	40	CLAY
			40	180	SAND
			0	0	
			0	0	
			0	0	
			0	0	
			0	0	
			0	0	

7 CONTRACTOR'S OR LANDOWNER'S CERTIFICATION: This water well was Plugged under my jurisdiction and was completed on (mo/day/year) 11/30/05 and this record is true to the best of my knowledge and belief. Kansas
 Water Well Contractor's License No. 145 This Water Well Record was completed on (mo/day/yr) 12/07/05
 under the business name of HENKLE DRILLING & SUPPLY by (signature) *Bruno J. Reichert*