USE TYPEWRITER OR BALL POINT PEN-PRESS FIRMLY, PRINT CLEARLY.

WATER WELL RECORD
KSA 82a-1201-1215

Kansas Department of Health and Environment-Division of Environment
(Water well Contractors)
Topeka, Kansas 66620

1. Location of well:	County	Fraction	Section number	Township number	Range number
	Scott	SW 1/4 SW 1/4 NE 1/4	5	T 20 S	R 33 E/W

2. Distance and direction from nearest town or city: 1S, 4½W, ½S of
Street address of well location if in city: Shallow Water, Kansas

3. Owner of well: Hattendorf Bros.
R.R. or street: Box 339
City, state, zip code: Scott City, KS 67871

4. Locate with "X" in section below:

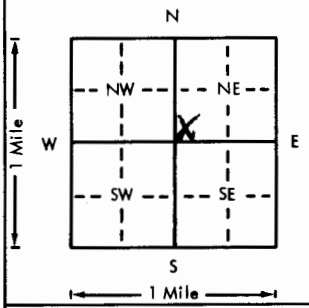

Sketch map:

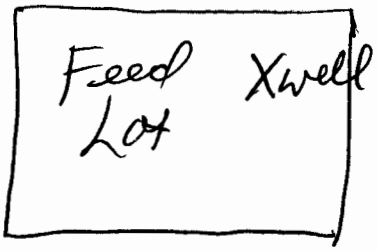

6. Bore hole dia. 9 in. Completion date
Well depth 155 ft. 7-27-76

7. __ Cable tool X Rotary __ Driven __ Dug
__ Hollow rod __ Jetted __ Bored __ Reverse rotary

8. Use: __ Domestic __ Public supply __ Industry
__ Irrigation __ Air conditioning X Stock
__ Lawn __ Oil field water __ Other

9. Casing: Material Plas. Height: Above or below
Threaded ___ Welded Glue Surface 12 in.
RMP X PVC ___ Weight 1.8 lbs./ft.
Dia. 5 in. to 115 ft. depth Wall Thickness: inches or
Dia. ___ in. to ___ ft. depth gage No. .250

5. Type and color of material	From	To
Clay	0	6
Sdy clay	6	40
Clay	40	68
Fine sd clay	68	80
Sd coarse	80	89
Clay	89	103
Sd coarse	103	110
Clay	110	117
Sd med	117	130
Fine sd clay	130	150
Yellow	150	150
Shale	152	155
(Use a second sheet if needed)		

10. Screen: Manufacturer's name Jess & Lowell
Type RMP Dia. 5 in.
Slot gauze 1/16 Length 40 ft.
Set between 115 ft. and 155 ft.
___ ft. and ___ ft.
Gravel pack? yes Size range of material ¼-1/8

11. Static water level: mo./day/yr.
105 ft. below land surface Date 6-21-76

12. Pumping level below land surfaces:
115 ft. after 1 hrs. pumping 28 g.p.m.
___ ft. after ___ hrs. pumping ___ g.p.m.
Estimated maximum yield 28 g.p.m.

13. Water sample submitted: mo./day/yr.
__ Yes X No Date

14. Well head completion:
X Pitless adapter 12 Inches above grade

15. Well grouted? yes
With: X Neat cement __ Bentonite __ Concrete
Depth: From 0 ft. to 15 ft.

16. Nearest source of possible contamination: In Feed Lot
ft. ___ Direction ___ Type
Well disinfected upon completion? X Yes __ No

17. Pump: __ Not installed
Manufacturer's name Red Jacket
Model number 300T1 HP 3 Volts 220
Length of drop pipe 147 ft. capacity 28 g.p.m.
Type:
X Submersible __ Turbine
__ Jet __ Reciprocating
__ Centrifugal __ Other

T 20 R 33 W Sec 5 1/4 1/4 1/4 SW NE

18. Elevation:

Topography:
__ Hill
__ Slope
X Upland
__ Valley

19. Remarks:

20. Water well contractor's certification:
This well was drilled under my jurisdiction and this report is true to the best of my knowledge and belief.
Weishaar Drilling 232
Business name License No.
Address Scott City, KS 67871
Signed [signature] Date
Authorized representative 8-17-76

Forward the white, blue and pink copies to the Department of Health and Environment

Form WWC-5

MI-1023