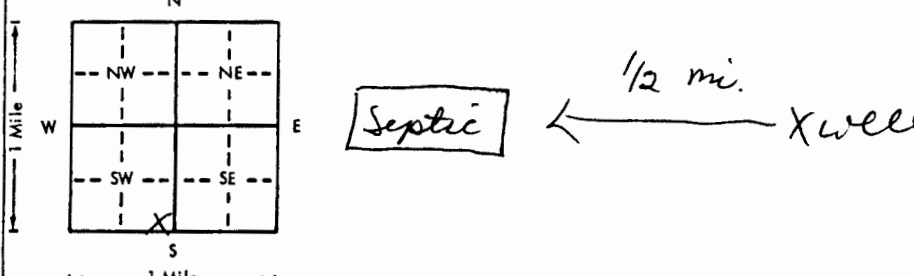


USE TYPEWRITER OR BALL POINT PEN-PRESS FIRMLY, PRINT CLEARLY.

WATER WELL RECORD
KSA 82a-1201-1215

Kansas Department of Health and Environment-Division of Environment
(Water well Contractors)
Topeka, Kansas 66620

| | | | | | | |
|---|----------------|------------------------|---|-----------------------------|--|--------------------------------|
| 1. Location of well: | | County Scott | Fraction SE 1/4 SE 1/4 SW 1/4 | Section number 11 | Township number T 20 S R 33 E 11 | Range number 33 E 11 |
| 2. Distance and direction from nearest town or city: 11S, 1 1/2 W of Street address of well location if in city: Scott City, Kansas | | | 3. Owner of well: Al Wasinger R.R. or street: RFD #2 City, state, zip code: Scott City, KS 67871 | | | |
| 4. Locate with "X" in section below: N W E S 1 Mile Sketch map:  | | | 6. Bore hole dia. <u>26</u> in. Completion date _____ Well depth <u>182</u> ft. <u>12-28-76</u> | | | |
| 5. Type and color of material | | | From | To | 7. <input type="checkbox"/> Cable tool <input type="checkbox"/> Rotary <input type="checkbox"/> Driven <input type="checkbox"/> Dug <input type="checkbox"/> Hollow rod <input type="checkbox"/> Jetted <input type="checkbox"/> Bored <input checked="" type="checkbox"/> Reverse rotary | |
| Clay | | | 0 | 20 | 8. Use: <input type="checkbox"/> Domestic <input type="checkbox"/> Public supply <input type="checkbox"/> Industry <input checked="" type="checkbox"/> Irrigation <input type="checkbox"/> Air conditioning <input type="checkbox"/> Stock <input type="checkbox"/> Lawn <input type="checkbox"/> Oil field water <input type="checkbox"/> Other | |
| Fine sd | | | 20 | 30 | 9. Casing: Material <u>Steel</u> Height: <u>Above</u> or below Threaded <input type="checkbox"/> Welded <input checked="" type="checkbox"/> Surface <u>10</u> in. RMP <input type="checkbox"/> PVC <input type="checkbox"/> Weight <u>31.67</u> lbs./ft. Dia. <u>16</u> in. to <u>182</u> ft. depth; Wall Thickness: inches or Dia. _____ in. to _____ ft. depth; gage No. <u>188</u> | |
| Clay | | | 30 | 40 | 10. Screen: Manufacturer's name _____ <u>Free Flow</u> Type <u>Prime Steel</u> Dia. <u>16 in.</u> <input checked="" type="checkbox"/> Slot gauze <u>.125</u> Length <u>50 ft.</u> Set between <u>132</u> ft. and <u>182</u> ft. _____ ft. and _____ ft. Gravel pack? <u>yes</u> Size range of material <u>3/4-1 1/4</u> | |
| Fine sd clay | | | 40 | 49 | 11. Static water level: _____ mo./day/yr. <u>90</u> ft. below land surface Date <u>11-9-76</u> | |
| Clay | | | 49 | 98 | 12. Pumping level below land surfaces: <u>146</u> ft. after <u>4</u> hrs. pumping <u>450</u> g.p.m. <u>148</u> ft. after <u>4</u> hrs. pumping <u>530</u> g.p.m. Estimated maximum yield <u>530</u> g.p.m. | |
| Gyp | | | 98 | 100 | 13. Water sample submitted: _____ mo./day/yr. <input type="checkbox"/> Yes <input checked="" type="checkbox"/> No Date _____ | |
| Clay | | | 100 | 107 | 14. Well head completion: <input type="checkbox"/> Pitless adapter _____ Inches above grade | |
| Gyp | | | 107 | 116 | 15. Well grouted? <u>yes</u> With: <input checked="" type="checkbox"/> Neat cement <input type="checkbox"/> Bentonite <input type="checkbox"/> Concrete Depth: From <u>0</u> ft. to <u>10</u> ft. | |
| Clay 'gyp str's' | | | 116 | 125 | 16. Nearest source of possible contamination: ft. <u>2640</u> Direction <u>West</u> Type <u>Septic</u> Well disinfected upon completion? <input checked="" type="checkbox"/> Yes <input type="checkbox"/> No | |
| Sd coarse | | | 125 | 137 | 17. Pump: _____ Not installed Manufacturer's name <u>Western Land Roller</u> Model number _____ HP _____ Volts _____ Length of drop pipe <u>170</u> ft. capacity <u>530</u> g.p.m. Type: <input type="checkbox"/> Submersible <input checked="" type="checkbox"/> Turbine <input type="checkbox"/> Jet <input type="checkbox"/> Reciprocating <input type="checkbox"/> Centrifugal <input type="checkbox"/> Other | |
| Sd rock | | | 137 | 138 | 20. Water well contractor's certification: This well was drilled under my jurisdiction and this report is true to the best of my knowledge and belief. <u>Weishaar Drilling</u> <u>232</u> Business name _____ License No. _____ Address <u>Scott City, KS 67871</u> Signed _____ Date _____ Authorized representative <u>1-11-77</u> | |
| Fine sd clay | | | 138 | 148 | | |
| Sd coarse | | | 148 | 152 | | |
| Clay | | | 152 | 155 | | |
| Sd 'med' | | | 155 | 160 | | |
| Clay (Use a second sheet if needed) | | | 160 | 172 | | |
| 18. Elevation: | 19. Remarks: | | | | | |
| | Sd fine to med | | 172 | 178 | | |
| | Clay yellow | | 178 | 181 | | |
| | Shale | | 181 | | | |
| Topography: | | | | | | |
| <input type="checkbox"/> Hill | | | | | | |
| <input type="checkbox"/> Slope | | | | | | |
| <input checked="" type="checkbox"/> Upland | | | | | | |
| <input type="checkbox"/> Valley | | | | | | |

Forward the white, blue and pink copies to the Department of Health and Environment

Form WWC-3