County: Scott Fraction SE Sec. 13 T 20 S R 33 E (W)

CORRECTION(S) TO WATER WELL COMPLETION RECORD (WWC-5)
(to rectify lacking or incorrect information)

Owner: E-Z Serve, Inc.

Location was listed as:	**Location changed to:**
Section-Township-Range: 15-20S-33	13-20S-33W
Fraction (¼ ¼ ¼): SE	SE

Other changes: Initial statements: 4 South of Shallow Water, 2¼ West, ¼ North.

Changed to: From Shallow Water: 3¾ mi. S., ¼ mi. W.

Comments:

Verification method: Note on USGS copy of WWC-5 from Keith Lebbin (former manager of GMD 1), other wells for same owner at same location, county ownership map, mapping tool on KGS website. initials: DRA date: 4/22/2015

Submitted by: Kansas Geological Survey, Data Resources Library, 1930 Constant Ave., Lawrence, KS 66047-3726
to: Kansas Dept of Health & Environment, Bureau of Water, 1000 SW Jackson, Suite 420, Topeka, KS 66612-1367.

USE TYPEWRITER OR BALL POINT PEN-PRESS FIRMLY, PRINT CLEARLY.

WATER WELL RECORD
KSA 82a-1201-1215

Kansas Department of Health and Environment-Division of Environment
(Water well Contractors)
Topeko, Kansas 66620

1. Location of well:	County	Fraction	Section number	Township number	Range number
	Scott County	1/4 1/4 SE 1/4	15	T 20 S	R 33 E/W

2. Distance and direction from nearest town or city: 4 South of Shallow Water, 2½ West, ½ North
Street address of well location if in city:

3. Owner of well: E-Z Serve, Inc.
R.R. or street: RFD 2
City, state, zip code: Scott City, KS 67871

4. Locate with "X" in section below:

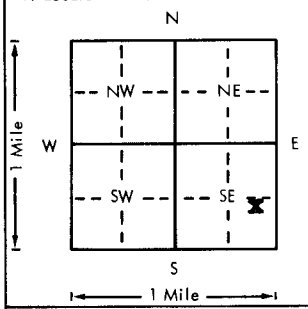

Sketch map:

6. Bore hole dia. 26 in. Completion date 4-29-79
Well depth 190 ft.

7. __ Cable tool __ Rotary __ Driven __ Dug
__ Hollow rod __ Jetted __ Bored X Reverse rotary

8. Use: __ Domestic __ Public supply __ Industry
X Irrigation __ Air conditioning __ Stock
__ Lawn __ Oil field water __ Other

9. Casing: Material Steel Height: Above or below
Threaded ____ Welded X Surface 1 ft. in.
RMP ____ PVC ____ Weight 33.38 lbs./ft.
Dia. 16 in. to 190 ft. depth Wall Thickness: inches or
Dia. ____ in. to ____ ft. depth gage No. .250

5. Type and color of material	From	To
Casing Schedule		
0 - 167 Plain 16"		
167 - 170 Swedge 16" to 10 3/4		
170 - 187 Screen 10 3/4		
187 - 190 Plain 10 3/4		
(Use a second sheet if needed)		

10. Screen: Manufacturer's name Johnson
Type Johnson Galv. Dia. 100-10 3/4 to 16"
Slot/gouze ____ Length ____
Set between ____ ft. and ____ ft.
____ ft. and ____ ft.
Grovel pack? yes Size range of material ¼ to 5/8

11. Static water level: mo./day/yr.
90 ft. below land surface Date 4-26-79

12. Pumping level below land surfaces:
160 ft. after 2 hrs. pumping 425 g.p.m.
160 ft. after bowls4 hrs. pumping 450 g.p.m. air
Estimated maximum yield 425 g.p.m.

13. Water sample submitted: mo./day/yr.
__ Yes X No Date ____

14. Well head completion:
X Pitless adapter ____ Inches above grade

15. Well grouted? yes
With: ____ Neat cement ____ Bentonite X Concrete
Depth: From 0 ft. to 10 ft.

16. Nearest source of possible contaminotion:
ft. ____ Direction N/A Type ____
Well disinfected upon completion? ____ Yes ____ No

17. Pump: __ Not installed
Manufacturer's name Gould 5 stg. 6" JHC Bowl
Model number Elec. Motor 20 Volts ____
Length of drop pipe 180 ft. capacity 350 g.p.m.
Type:
____ Submersible X Turbine
____ Jet ____ Reciprocating
____ Centrifugal ____ Other

18. Elevation:

Topography:
____ Hill
____ Slope
X Upland
____ Valley

19. Remarks:

20. Water well contractor's certification:
This well wos drilled under my jurisdiction and this report is true to the best of my knowledge and belief.
Minter Wilson Drilling Co. 208
Business name License No.
Address Box A, Garden City, KS 67846
Signed Authorized representative Date 5-17-79

T 20 S 33 E Sec 15 1/4 1/4 1/4

Forward the white, blue and pink copies to the Department of Health and Environment

Form WWC-5

MI-1023

Phone 276-8269 • P.O. Box A • GARDEN CITY, KANSAS 67846

January 26, 1979

E-Z Serve Inc.
Scott County

Location: S. E. ¼ 15-20-33 North end of Refinery
Static Water Level - 85
Test #

0	1	Top Soil
1	35	Brown Clay
35	41	Brown Clay and Sand
41	81	Brown Clay
81	96	Fine to med. sand and gravel (loose)
96	129	Brown Clay & White Rock (tight) (hard streaks)
129	140	Fine to med. sand and gravel (loose)
140	147	Fine to med. sand and gravel 30% Clay (loose)
147	155	Fine to med. sand and gravel (loose)
155	170	Fine to med. sand and fine gravel 10% Clay (loose)
170	187	Fine to med. sand and gravel (loose)
187	193	Yellow Clay (tight)
193	200	Shale (tight)