USE TYPEWRITER OR BALL POINT PEN-PRESS FIRMLY, PRINT CLEARLY.

WATER WELL RECORD
KSA 82a-1201-1215

Kansas Department of Health and Environment-Division of Environment
(Water well Contractors)
Topeka, Kansas 66620

1. Location of well:	County	Fraction	Section number	Township number	Range number
	Scott	S/W 1/4 S/W 1/4 N/W 1/4	24	T 20 S	R 33 E/W

2. Distance and direction from nearest town or city:
1W, 5S. of Shallow Water, Kansas
Street address of well location if in city:

3. Owner of well: Edwin Cheney
R.R. or street: RFD #2
City, state, zip code: Scott City, Kansas 67871

4. Locate with "X" in section below:

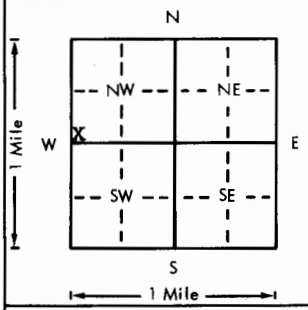

Sketch map:

well X ----- 300' -------- Feed lot X

6. Bore hole dia. 9 in. Completion date
Well depth 180 ft. 10-25-1977

7. __ Cable tool X Rotary __ Driven __ Dug
__ Hollow rod __ Jetted __ Bored __ Reverse rotary

8. Use: X Domestic __ Public supply __ Industry
__ Irrigation __ Air conditioning __ Stock
__ Lawn __ Oil field water __ Other

9. Casing: Material Plastic glue Height: Above or below
Threaded ___ Welded ___ Surface 12 in.
RMP X PVC ___ Weight 1.8 lbs./ft.
Dia. 5 in. to 160 ft. depth Wall Thickness: inches or
Dio. ___ in. to ___ ft. depth gage No. .250

5. Type and color of material	From	To
Clay	0	33
Fine sand clay	33	55
Clay	55	82
Fine sand Clay	82	95
Sand coarse	95	115
Fine sand clay	114	157
Sand coarse	157	177
Clay yellow	177	180
(Use a second sheet if needed)		

10. Screen: Monufacturer's name Jess & Lowell
Type RMP Dia. 5"
Slot/gauze 1/16" Length 20'
Set between 160 ft. and 180 ft.
___ ft. and ___ ft.
Gravel pack? yes Size range of material 1/4-1/8"

11. Static water level: mo./day/yr.
99 ft. below land surface Date 10-24-1977

12. Pumping level below land surfaces:
130 ft. after 4 hrs. pumping 10 g.p.m.
___ ft. after ___ hrs. pumping ___ g.p.m.
Estimated maximum yield 10 g.p.m.

13. Water sample submitted: mo./day/yr.
__ Yes X No Date

14. Well head completion:
X Pitless adapter 12 Inches above grade

15. Well grouted? yes
With: X Neat cement __ Bentonite __ Concrete
Depth: From 0 ft. to 15 ft.

16. Nearest source of possible contamination:
ft. 300 Direction East Type Feed lot
Well disinfected upon completion? X Yes __ No

17. Pump: __ Not installed
Manufacturer's name Red Jacket
Model number 11BB HP 1 Volts 230
Length of drop pipe 165 ft. capacity 10 g.p.m.
Type:
X Submersible __ Turbine
__ Jet __ Reciprocating
__ Centrifugal __ Other

18. Elevation:

Topography:
__ Hill
__ Slope
X Upland
__ Valley

19. Remarks:

20. Water well contractor's certification:
This well was drilled under my jurisdiction and this report is true to the best of my knowledge and belief.
Weishaar Drilling & Sup. 232
Business name License No.
Address Scott City, Ks. 67871
Signed [signature] Date 10-26-77
Authorized representative

T 20 R 33 E/W Sec 24 1/4 1/4 1/4 SW SW NW

Forward the white, blue and pink copies to the Department of Health and Environment

Form WWC-5

MI-1023