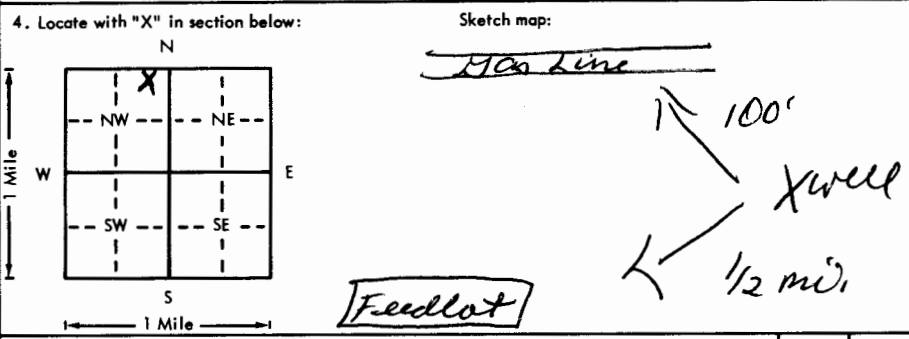


USE TYPEWRITER OR BALL POINT PEN-PRESS FIRMLY, PRINT CLEARLY.

WATER WELL RECORD
KSA 82a-1201-1215

Kansas Department of Health and Environment-Division of Environment
(Water well Contractors)
Topeka, Kansas 66620

1. Location of well:		County Scott	Fraction NE 1/4 NE 1/4 NW 1/4	Section number 24	Township number T 20 S R 33 E 20	Range number 33
2. Distance and direction from nearest town or city: 12S, 3/4W of Street address of well location if in city: Scott City, Kansas			3. Owner of well: Edwin Cheney R.R. or street: RFD #2 City, state, zip code: Scott City, KS 67871			
4. Locate with "X" in section below: 			6. Bore hole dia. 26 in. Completion date _____ Well depth 185 ft. 10-26-76			
5. Type and color of material			7. <input type="checkbox"/> Cable tool <input type="checkbox"/> Rotary <input type="checkbox"/> Driven <input type="checkbox"/> Dug <input type="checkbox"/> Hollow rod <input type="checkbox"/> Jetted <input type="checkbox"/> Bored <input checked="" type="checkbox"/> Reverse rotary			
			8. Use: <input type="checkbox"/> Domestic <input type="checkbox"/> Public supply <input type="checkbox"/> Industry <input checked="" type="checkbox"/> Irrigation <input type="checkbox"/> Air conditioning <input type="checkbox"/> Stock <input type="checkbox"/> Lawn <input type="checkbox"/> Oil field water <input type="checkbox"/> Other			
			9. Casing: Material Steel Height: 60 or below Threaded _____ Welded <input checked="" type="checkbox"/> Surface 10 in. RMP _____ PVC _____ Weight 31.67 lbs./ft. Dia. 16 in. to 185 ft. depth; Wall Thickness: _____ inches or Dia. _____ in. to _____ ft. depth; gauge No. 188			
			10. Screen: Manufacturer's name _____ Free Flow Type Prime Steel Dia. 16 in. <input checked="" type="checkbox"/> Slotted gauge .125 Length 40 ft. Set between 145 ft. and 185 ft. _____ ft. and _____ ft. Gravel pack? yes Size range of material 3/4-1/4			
			11. Static water level: _____ mo./day/yr. 80 ft. below land surface Date 7-26-76			
			12. Pumping level below land surfaces: 147 ft. after 4 hrs. pumping 1150 g.p.m. 150 ft. after 4 hrs. pumping 1240 g.p.m. Estimated maximum yield 1240 g.p.m.			
			13. Water sample submitted: _____ mo./day/yr. Yes <input checked="" type="checkbox"/> No <input type="checkbox"/> Date _____			
			14. Well head completion: <input type="checkbox"/> Pitless adapter _____ Inches above grade			
			15. Well grouted? yes With: <input checked="" type="checkbox"/> Neat cement <input type="checkbox"/> Bentonite <input type="checkbox"/> Concrete Depth: From 0 ft. to 10 ft.			
			16. Nearest source of possible contamination: Gas ft. 100 Direction NW Type Line Well disinfected upon completion? <input checked="" type="checkbox"/> Yes <input type="checkbox"/> No			
			17. Pump: _____ Not installed Manufacturer's name Western Land Roller Model number _____ HP _____ Volts _____ Length of drop pipe 175 ft. capacity 1240 g.p.m. Type: <input type="checkbox"/> Submersible <input checked="" type="checkbox"/> Turbine <input type="checkbox"/> Jet <input type="checkbox"/> Reciprocating <input type="checkbox"/> Centrifugal <input type="checkbox"/> Other			
			(Use a second sheet if needed)			
18. Elevation:		19. Remarks:				
Topography: <input type="checkbox"/> Hill <input checked="" type="checkbox"/> Slope <input type="checkbox"/> Upland <input type="checkbox"/> Valley		20. Water well contractor's certification: This well was drilled under my jurisdiction and this report is true to the best of my knowledge and belief. Weishaar Drilling 232 Business name License No. Scott City, KS 67871 Address Signed [Signature] Date 11-5-76 Authorized representative				

T 20
 R 33
 E
 Sec 24
 NE 1/4 NW 1/4

Forward the white, blue and pink copies to the Department of Health and Environment

Form WW-5