


1 LOCATION OF WATER WELL: Fraction SE 1/4 NE 1/4 SE 1/4 Section Number 2 Township Number T 20 S Range Number R 34 E/W)
 County: Scott
 Distance and direction from nearest town or city street address of well if located within city?

2 WATER WELL OWNER: Gordon Schmidt
 RR#, St. Address, Box # : Board of Agriculture, Division of Water Resources
 City, State, ZIP Code : Scott City, Ks. 67871 Application Number:

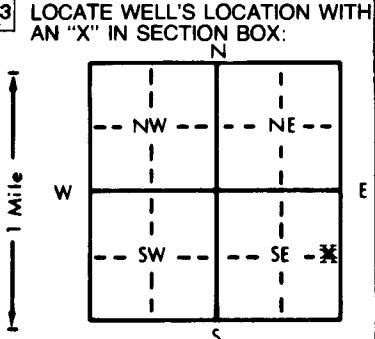

4 DEPTH OF COMPLETED WELL... 117 ft. ELEVATION:
 Depth(s) Groundwater Encountered 1. ft. 2. ft. 3. ft.
 WELL'S STATIC WATER LEVEL . . . 94 ft. below land surface measured on mo/day/yr . . . 2-1-94
 Pump test data: Well water was ft. after hours pumping gpm
 Est. Yield . . . 20 gpm: Well water was ft. after hours pumping gpm
 Bore Hole Diameter . . . 10 in. to . . . 117 ft., and in. to ft.
 WELL WATER TO BE USED AS: 5 Public water supply 8 Air conditioning 11 Injection well
 Domestic 3 Feedlot 6 Oil field water supply 9 Dewatering 12 Other (Specify below)
 2 Irrigation 4 Industrial 7 Lawn and garden only 10 Monitoring well
 Was a chemical/bacteriological sample submitted to Department? Yes No ; If yes, mo/day/yr sample was sub-
 mitted Water Well Disinfected? Yes No

5 TYPE OF BLANK CASING USED: 5 Wrought iron 8 Concrete tile CASING JOINTS: Glued Clamped
 1 Steel 3 RMP (SR) 6 Asbestos-Cement 9 Other (specify below) Welded
 PVC 4 ABS 7 Fiberglass Threaded
 Blank casing diameter . . . 5 in. to . . . 117 ft., Dia in. to ft., Dia in. to ft.
 Casing height above land surface . . . 12 in., weight lbs./ft. Wall thickness or gauge No. . . 200 .psi
 TYPE OF SCREEN OR PERFORATION MATERIAL: PVC 10 Asbestos-cement
 1 Steel 3 Stainless steel 5 Fiberglass 8 RMP (SR) 11 Other (specify)
 2 Brass 4 Galvanized steel 6 Concrete tile 9 ABS 12 None used (open hole)
 SCREEN OR PERFORATION OPENINGS ARE: 5 Gauzed wrapped 8 Saw cut 11 None (open hole)
 1 Continuous slot 3 Mill slot 6 Wire wrapped 9 Drilled holes
 2 Louvered shutter 4 Key punched 7 Torch cut 10 Other (specify)
 SCREEN-PERFORATED INTERVALS: From . . . 97 ft. to . . . 117 ft., From ft. to ft.
 From ft. to ft., From ft. to ft.
 GRAVEL PACK INTERVALS: From ft. to ft., From ft. to ft.
 From ft. to ft., From ft. to ft.

6 GROUT MATERIAL: 1 Neat cement 2 Cement grout Bentonite chips Other
 Grout Intervals: From . . . 5 ft. to . . . 25 ft., From . . . 55 ft. to . . . hole plug, From ft. to ft.
 What is the nearest source of possible contamination: to 60' 10 Livestock pens 14 Abandoned water well
 Septic tank 4 Lateral lines 7 Pit privy 11 Fuel storage 15 Oil well/Gas well
 2 Sewer lines 5 Cess pool 8 Sewage lagoon 12 Fertilizer storage 16 Other (specify below)
 3 Watertight sewer lines 6 Seepage pit 9 Feedyard 13 Insecticide storage
 Direction from well? How many feet? 100

FROM	TO	LITHOLOGIC LOG	FROM	TO	PLUGGING INTERVALS
0	1	hole plug			
1	41	brown clay			
41	51	medium to coarse sand			
51	70	brown clay			
70	102	medium to coarse sand, some small gravel			
102	113	fine to medium & coarse sand			
113	115	yellow clay			
115	117	black shale			

7 CONTRACTOR'S OR LANDOWNER'S CERTIFICATION: This water well was constructed, (2) reconstructed, or (3) plugged under my jurisdiction and was completed on (mo/day/year) . . . 2-1-94 and this record is true to the best of my knowledge and belief. Kansas Water Well Contractor's License No. . . . 532 This Water Well Record was completed on (mo/day/yr) . . . 2-8-94 under the business name of Midwest Well & Pump by (signature) Victor Jankup

OFFICE USE ONLY T R E/W SEC. 1/4 1/4 1/4