USE TYPEWRITER OR BALL POINT PEN-PRESS FIRMLY, PRINT CLEARLY.

WATER WELL RECORD
KSA 82a-1201-1215

Konsas Department of Health and Environment-Division of Environment
(Water well Contractors)
Topeka, Kansas 66620

1. Location of well:	County	Fraction	Section number	Township number	Range number
	Scott	SE 1/4 SE 1/4 SE 1/4	9	T 20 S	R 34 E (W)

2. Distance and direction from nearest town or city: 11S, 9W of
Street address of well location if in city: Scott City, KS

3. Owner of well: Chas. Moore
R.R. or street:
City, state, zip code: Modoc, KS 67866

4. Locate with "X" in section below:

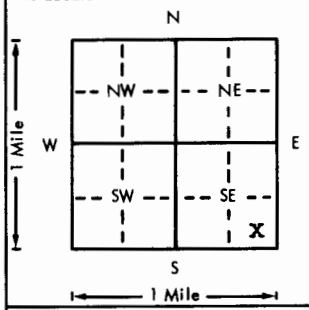

Sketch map:

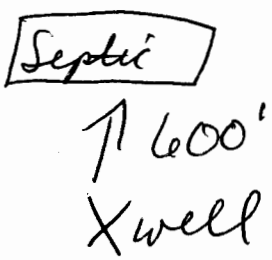

6. Bore hole dia. 18 in. Completion date 4-7-76
Well depth 160 ft.

7. __ Cable tool X Rotary __ Driven __ Dug
__ Hollow rod __ Jetted __ Bored __ Reverse rotary

8. Use: __ Domestic __ Public supply __ Industry
X Irrigation __ Air conditioning __ Stock
__ Lawn __ Oil field water __ Other

9. Casing: Material Plas. Glue Height: (Above) or below
Threaded __ Welded __ Surface 12 in.
RMP X PVC __ Weight 3 lbs./ft.
Dia. 8 in. to 160 ft. depth Wall Thickness: inches or
Dia. __ in. to __ ft. depth gage No. .250

5. Type and color of material	From	To
Clay	0	12
Gyp	12	30
Sdy clay	30	55
Fine sd clay	55	77
Sd coarse	77	83
Sd med	83	90
Sd rock	90	92
Sd coarse	92	110
Med sd good	110	130
Clay	130	136
Fine sd clay	136	145
Clay sdy	145	152
Shale	152	160
(Use a second sheet if needed)		

10. Screen: Manufacturer's name Jess & Lowell
Type RMP Dia. 8 in.
Slot (gauze) 1/8 Length 50 ft.
Set between 110 ft. and 160 ft.
ft. and ft.
Gravel pack? yes Size range of material 1/2-1/4

11. Static water level: mo./day/yr.
110 ft. below land surface Date 3-17-76

12. Pumping level below land surfaces: NA
ft. after hrs. pumping g.p.m.
ft. after hrs. pumping g.p.m.
Estimated maximum yield g.p.m.

13. Water sample submitted: mo./day/yr.
__ Yes X No Date

14. Well head completion:
__ Pitless adapter 12 inches above grade

15. Well grouted? ✓
With: ✓ Neat cement __ Bentonite __ Concrete
Depth: From 0 ft. to 10 ft.

16. Nearest source of possible contamination:
ft. 600 Direction N Type Septic
Well disinfected upon completion? X Yes __ No

17. Pump: __ Not installed
Manufacturer's name Goulds
Model number UH66LL34 HP 10 Volts 460
Length of drop pipe 100 ft. capacity 100 g.p.m.
Type:
X Submersible __ Turbine
__ Jet __ Reciprocating
__ Centrifugal __ Other

18. Elevation:

Topography:
__ Hill
__ Slope
X Upland
__ Valley

19. Remarks:

20. Water well contractor's certification:
This well was drilled under my jurisdiction and this report is true to the best of my knowledge and belief. 232
Business name Weishaar Drilling License No. 232
Address Scott City, KS 67871
Signed [signature] Date
Authorized representative 7-21-76

T 20 S R 34 E (W) Sec 9 1/4 1/4 1/4

Forward the white, blue and pink copies to the Department of Health and Environment

Form WWC-5

M1-1023