USE TYPEWRITER OR BALL POINT PEN-PRESS FIRMLY, PRINT CLEARLY.

WATER WELL RECORD
KSA 82a-1201-1215

Kansas Department of Health and Environment-Division of Environment
(Water well Contractors)
Topeko, Kansas 66620

1. Location of well:	County	Fraction	Section number	Township number	Range number
	Scott	1/4 C 1/4 SW1/4	12	T 20 S	R 34 ~~E~~ W

2. Distance and direction from nearest town or city:
3 mi S, 7 mi W of Shallow Water, Ks.
Street address of well location if in city:

3. Owner of well: Berl Minnix
R.R. or street: Modoc
City, state, zip code: Ks. 67866

4. Locate with "X" in section below:

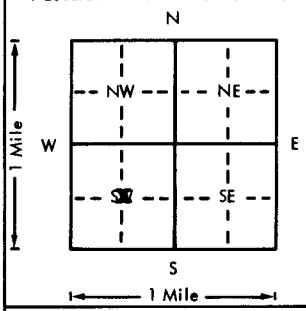

Sketch map:

C of qtr

6. Bore hole dia. 18½ in. Completion date _____
Well depth 139 ft. 5/25/76

7. __ Cable tool X Rotary __ Driven __ Dug
__ Hollow rod __ Jetted __ Bored __ Reverse rotary

8. Use: __ Domestic __ Public supply __ Industry
X Irrigation __ Air conditioning __ Stock
__ Lawn __ Oil field water __ Other

9. Casing: Material Steel
Threaded ___ Welded X
RMP ___ PVC ___
Dia. 12 3/4 to 139 ft. depth
Dia. ___ in. to ___ ft. depth
Height: Above or below Surface 12 in.
Weight 27.30 lbs./ft.
Wall Thickness: inches or gage No. 203

5. Type and color of material	From	To
Clay	0	20
Gyp	20	60
Gyp, sand	60	80
Sand, clay	80	100
SAND , gravel	100	130
Clay, shale	130	139
(Use a second sheet if needed)		

10. Screen: Manufacturer's name Lakewood
Type Millslot Dia. 12 3/4
Slot/gauze 1/8x2" Length 41
Set between 98 ft. and 139 ft.
___ ft. and ___ ft.
Gravel pack? Yes Size range of material 1x1/8

11. Static water level: mo./day/yr.
96 ft. below land surface Date 5/18/76

12. Pumping level below land surfaces:
135 ft. after 5 hrs. pumping 400 g.p.m.
___ ft. after ___ hrs. pumping ___ g.p.m.
Estimated maximum yield 400 g.p.m.

13. Water sample submitted: mo./day/yr.
___ Yes X No Date ___

14. Well head completion:
___ Pitless adapter 12 inches above grade

15. Well grouted? Yes
With: ___ Neat cement ___ Bentonite X Concrete
Depth: From 0 ft. to 10 ft.

16. Nearest source of possible contamination: NA
ft. ___ Direction ___ Type ___
Well disinfected upon completion? ___ Yes X No

17. Pump: Not installed
Manufacturer's name Used Winthropt
Model number Unknown HP ___ Volts ___
Length of drop pipe 130 ft. capacity 400 g.p.m.
Type:
___ Submersible X Turbine
___ Jet ___ Reciprocating
___ Centrifugal ___ Other

T 20 R 34 E W Sec 12 1/4 C SE 1/4

18. Elevation:

Topography:
___ Hill
___ Slope
X Upland
___ Valley

19. Remarks:

20. Water well contractor's certification:
This well was drilled under my jurisdiction and this report is true to the best of my knowledge and belief.
High Plains Drilling & Supply, Inc. 136 A
Business name License No.
Address 402 N 3rd, Garden City, Ks.
Signed Roy D Hankins Date 6-3-76
Authorized representative

Forward the white, blue and pink copies to the Department of Health and Environment

Form WWC-5

MI-1023